



Village of Menomonee Falls
W156 N8480 Pilgrim Road
Menomonee Falls, WI 53051-3140
Telephone: (262) 532-4200

STORMWATER MANAGEMENT FACILITIES OPERATION AND INSPECTION REPORT

Quarter Section SE ¼ SEC 22 Name of Business/Subdivision FOX MEADOW
Property Tax ID Number _____ Address of Property _____
Date 12-03-2021 _____

Dry Pond	X
Wet Pond	
Other	

Location of Pond OUTLOT 10
Pond ID: SWP22S009

Year Pond Constructed 2016 Year of Last Certification 2016

Compliance Verification	Design	Actual	Compliant Yes No	Comments (Condition of Structure)
Primary Outlet Pipe				Outlet Pipe Material
Opening Diameter (inches)	12	12	X	Reinforced concrete pipe Good Condition
Upstream Invert	845.00	844.82	X	
Downstream Invert	844.48	844.40	X	
Length (feet)	104.0	104.0	X	
Slope (%)	0.50	0.40	X	
Secondary Outlet Pipe	(If Applicable)			Outlet Pipe Material
Opening Diameter (inches)	NA			NA
Upstream Invert	NA			
Downstream Invert	NA			
Length (feet)	NA			
Slope (%)	NA			
Riser	(If Applicable)			Riser Material
Opening Diameter (inches)	NA			
Elevation	NA			
Upper Discharge Control	(If Applicable)			
Opening Diameter (inches)	NA			
Elevation	NA			

Compliance Verification	Design	Actual	Compliant Yes No		Comments	
Lower Discharge Control	(If Applicable)					
Opening Diameter (inches)	NA					
Elevation	NA					
Other (Description)						
Opening Type and Size (inches)	NA					
Elevation	NA					
Emergency Spillway						
Elevation	848.90	848.83	X		Good Condition	
Length of spillway (feet)	10	10	X		Good Condition	
Embankment	Present Yes No		Comments/Maintenance Requirements			
Unauthorized Plantings, trees, or woody vegetation		X				
Animal burrows or slope erosion		X				
Storm Sewer Outfalls	Type & Size		Location		Comments	
Outfall 1						
Outfall 2						
Outfall 3						
Storage Properties	Design	Actual	Compliant Yes No		Not Applicable	Equipment Used
Normal Water Elevation (Wet Ponds)						Trimble Total Station & GPS
Design High Water Elevation	848.22	848.22	X			
Area at Normal Water Elevation (Ac) (Wet Ponds)						
Area at Design High Water Elevation (Ac)	0.07	0.07	X			
Active Storage Available (Ac-Ft)*	0.16	0.16	X			
Lowest Elevation at Top of Embankment (If Applicable)						
Average Elevation at Top of Embankment (If Applicable)	850.00	849.90	X			
Maximum Bottom Elevation	845.00	844.67	X			
Average Pond Bottom Elevation	845.00	844.98	X			
Pond Bottom Area (Ac)	0.01	0.01	X			
Maximum Pond Depth	3.9'	3.9'	X			
Average Pond Depth	3.9'	3.9'	X			
Average Permanent Pool Depth (Wet Ponds)						

*To Determine Active Storage $V = H/3(A1 + A2 + (A1 \times A2)^{1/2})$

Wet Ponds Use H = Height of Section, $A1$ = area at normal water elevation, $A2$ = area at top section

Dry Ponds Use H = Height of Section, $A1$ = pond bottom area, $A2$ = area at top section

Figure 1: Pond 1A As-Built Detail

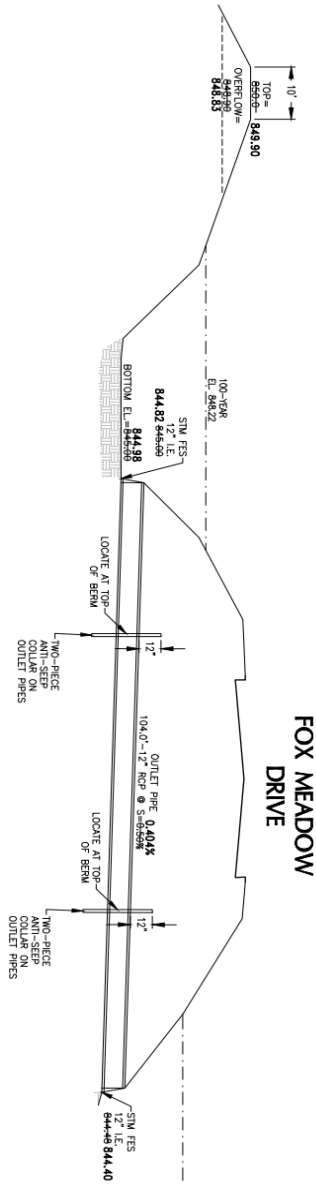


Figure 2: Pond 1A Facing West



Figure 3: Pond 1A Facing North



Inspection Firm: TRIO ENGINEERING, LLC
 Phone Number: 262-790-1480
 Address: 4100 N. Calhoun Road
Brookfield, WI 53005

Inspector Name : Daniel Scherer
 Inspection Date: 12-01-2021

Certifying Professional
 Name: Daniel Scherer
 Phone Number: 262-790-1480



Date: 12/03/21
 Signature: Dan Scherer

Affix Seal Here