



Village of Menomonee Falls
W156 N8480 Pilgrim Road
Menomonee Falls, WI 53051-3140
Telephone: (262) 532-4200

STORMWATER MANAGEMENT FACILITIES OPERATION AND INSPECTION REPORT

Quarter Section 35 NW Name of Business/Subdivision WILLOWOOD PARK
Property Tax ID Number 0138999002 Address of Property BADGER DR
MENOMONEE FALLS, WI 53051

Dry Pond	
Wet Pond	X
Other	

Description: SWP35N006
P-0242

Location Of Pond SE CORNER OF SILVER SPRING
& BADGER DR

Year Pond Constructed 1968 Year of Last Certification N/A

Compliance Verification	Design	Actual	Compliant Yes	No	Comments (Condition of Structure)
Primary Outlet Pipe					Outlet Pipe Material
Opening Diameter (inches) (ST015376)	N/A	N/A			N/A
Upstream Invert	N/A	N/A			
Downstream Invert	N/A	N/A			
Length (feet)	N/A	N/A			
Slope (%)	N/A	N/A			
Secondary Outlet Pipe	(If Applicable)				Outlet Pipe Material
Opening Diameter (inches)					
Upstream Invert					
Downstream Invert					
Length (feet)					
Slope (%)					
Riser	(If Applicable)				Riser Material
Opening Diameter (inches)					IN GOOD CONDITION.
Elevation					
Upper Discharge Control	(If Applicable)				
Opening Diameter (inches)					
Elevation					

Compliance Verification	Design	Actual	Compliant Yes No		Comments		
Lower Discharge Control	(If Applicable)						
Opening Diameter (inches)							
Elevation							
Other (Description)							
Opening Type and Size (inches)							
Elevation							
Emergency Spillway							
Elevation	N/A	777.41	-		ONLY OUTFLOW FEATURE		
Length of spillway (feet)	N/A	10.5	-				
Embankment	Present Yes No		Comments/Maintenance Requirements				
Unauthorized Plantings, trees, or woody vegetation	X		VARIETY OF VEGETATION GROWING AROUND LAGOON. NO IMPAIRMENT TO ANY DRAINAGE AT THIS TIME. NO NEED TO REMOVE ANY VEGETATION AT THIS TIME.				
Animal burrows or slope erosion		X					
Storm Sewer Outfalls	Type & Size		Location		Comments		
Outfall 1 (ST020327)	12” CORGTD PVC		SW CORNER OF POND		PVC IN GOOD CONDITION, 776.70		
Outfall 2							
Outfall 3							
Storage Properties	Design	Actual	Compliant Yes No		Not Applicable	Equipment Used	
Normal Water Elevation <i>(Wet Ponds)</i>	N/A	777.46	-			GPS EQUIPMENT: GEOMAX ZENITH35 & CARLSON SURVEYOR2 WITH SURV CE v5.04 ELEVATIONS TO VARY SLIGHTLY FROM YEAR TO YEAR DUE TO GPS TECHNOLOGY	
Design High Water Elevation	N/A	778.50	-				
Area at Normal Water Elevation (Ac) (Wet Ponds)	N/A	1.794 AC	-				
Area at Design High Water Elevation (Ac)	N/A	1.998 AC	-				
Active Storage Available (Ac-Ft)*	N/A	1.989 ACFT	-				
Lowest Elevation at Top of Embankment (If Applicable)	N/A	778.20	-				
Average Elevation at Top of Embankment (If Applicable)	N/A	779.50	-				
Maximum Bottom Elevation	N/A	771.16	-				
Average Pond Bottom Elevation	N/A	774.00	-				
Pond Bottom Area (Ac)	N/A	0.782 AC	-				
Maximum Pond Depth	N/A	7.3 FT	-				
Average Pond Depth	N/A	4.5 FT	-				
Average Permanent Pool Depth <i>(Wet Ponds)</i>	N/A	3.5 FT	-				

*To Determine Active Storage $V = \left(\left(\frac{H}{3} \right) \left(A1 + A2 + \left(\left(A1 + A2 \right)^{\left(\frac{1}{2} \right)} \right) \right) \right)$
Wet Ponds Use H = Height of Section , $A1$ = area at normal water elevation, $A2$ =area at top section
Dry Ponds Use H = Height of Section, $A1$ = pond bottom area, $A2$ =area at top section

Willowood Park Lagoon – SWP26N006

Overview



Storm Water Outlet ST020327



Willowood Park Lagoon – SWP26N006

Spillway at E End of Lagoon



Swale Leading to NW Corner of Lagoon



Willowood Park Lagoon – SWP26N006

Repairs Needed (11/08/21)

None

Sketch Outlet

Place Photograph of Pond

Place Photograph of Pond

Inspection Firm: VILLAGE OF
MENOMONEE FALLS
Phone Number: (262) 532-4411
Address: VILLAGE OF
MENOMONEE FALLS
W156N8480 PILGRIM RD
MENOMONEE FALLS, WI
53051

Inspector Name : CHRISTOPHER M. GARIEPY

Inspection Date: NOVEMBER 8, 2021

Certifying

Professional Name: THOMAS M. HOFFMAN, P.E.

Phone Number: (262) 532-4415


Date:

4/14/2022

Signature:



Affix Seal Here

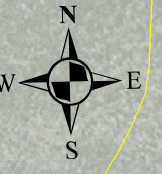


0.765 15 22.5 30 Feet
1 inch = 30 feet

Water Elevation
November 8, 2021
was 777.46.

SWP35N006

SWP35N006
Willowood Park Pond
2021 Pond Inspection
Land Survey 10/20/2021 CMG
Pond Bottom Survey 11/08/2021 CMG

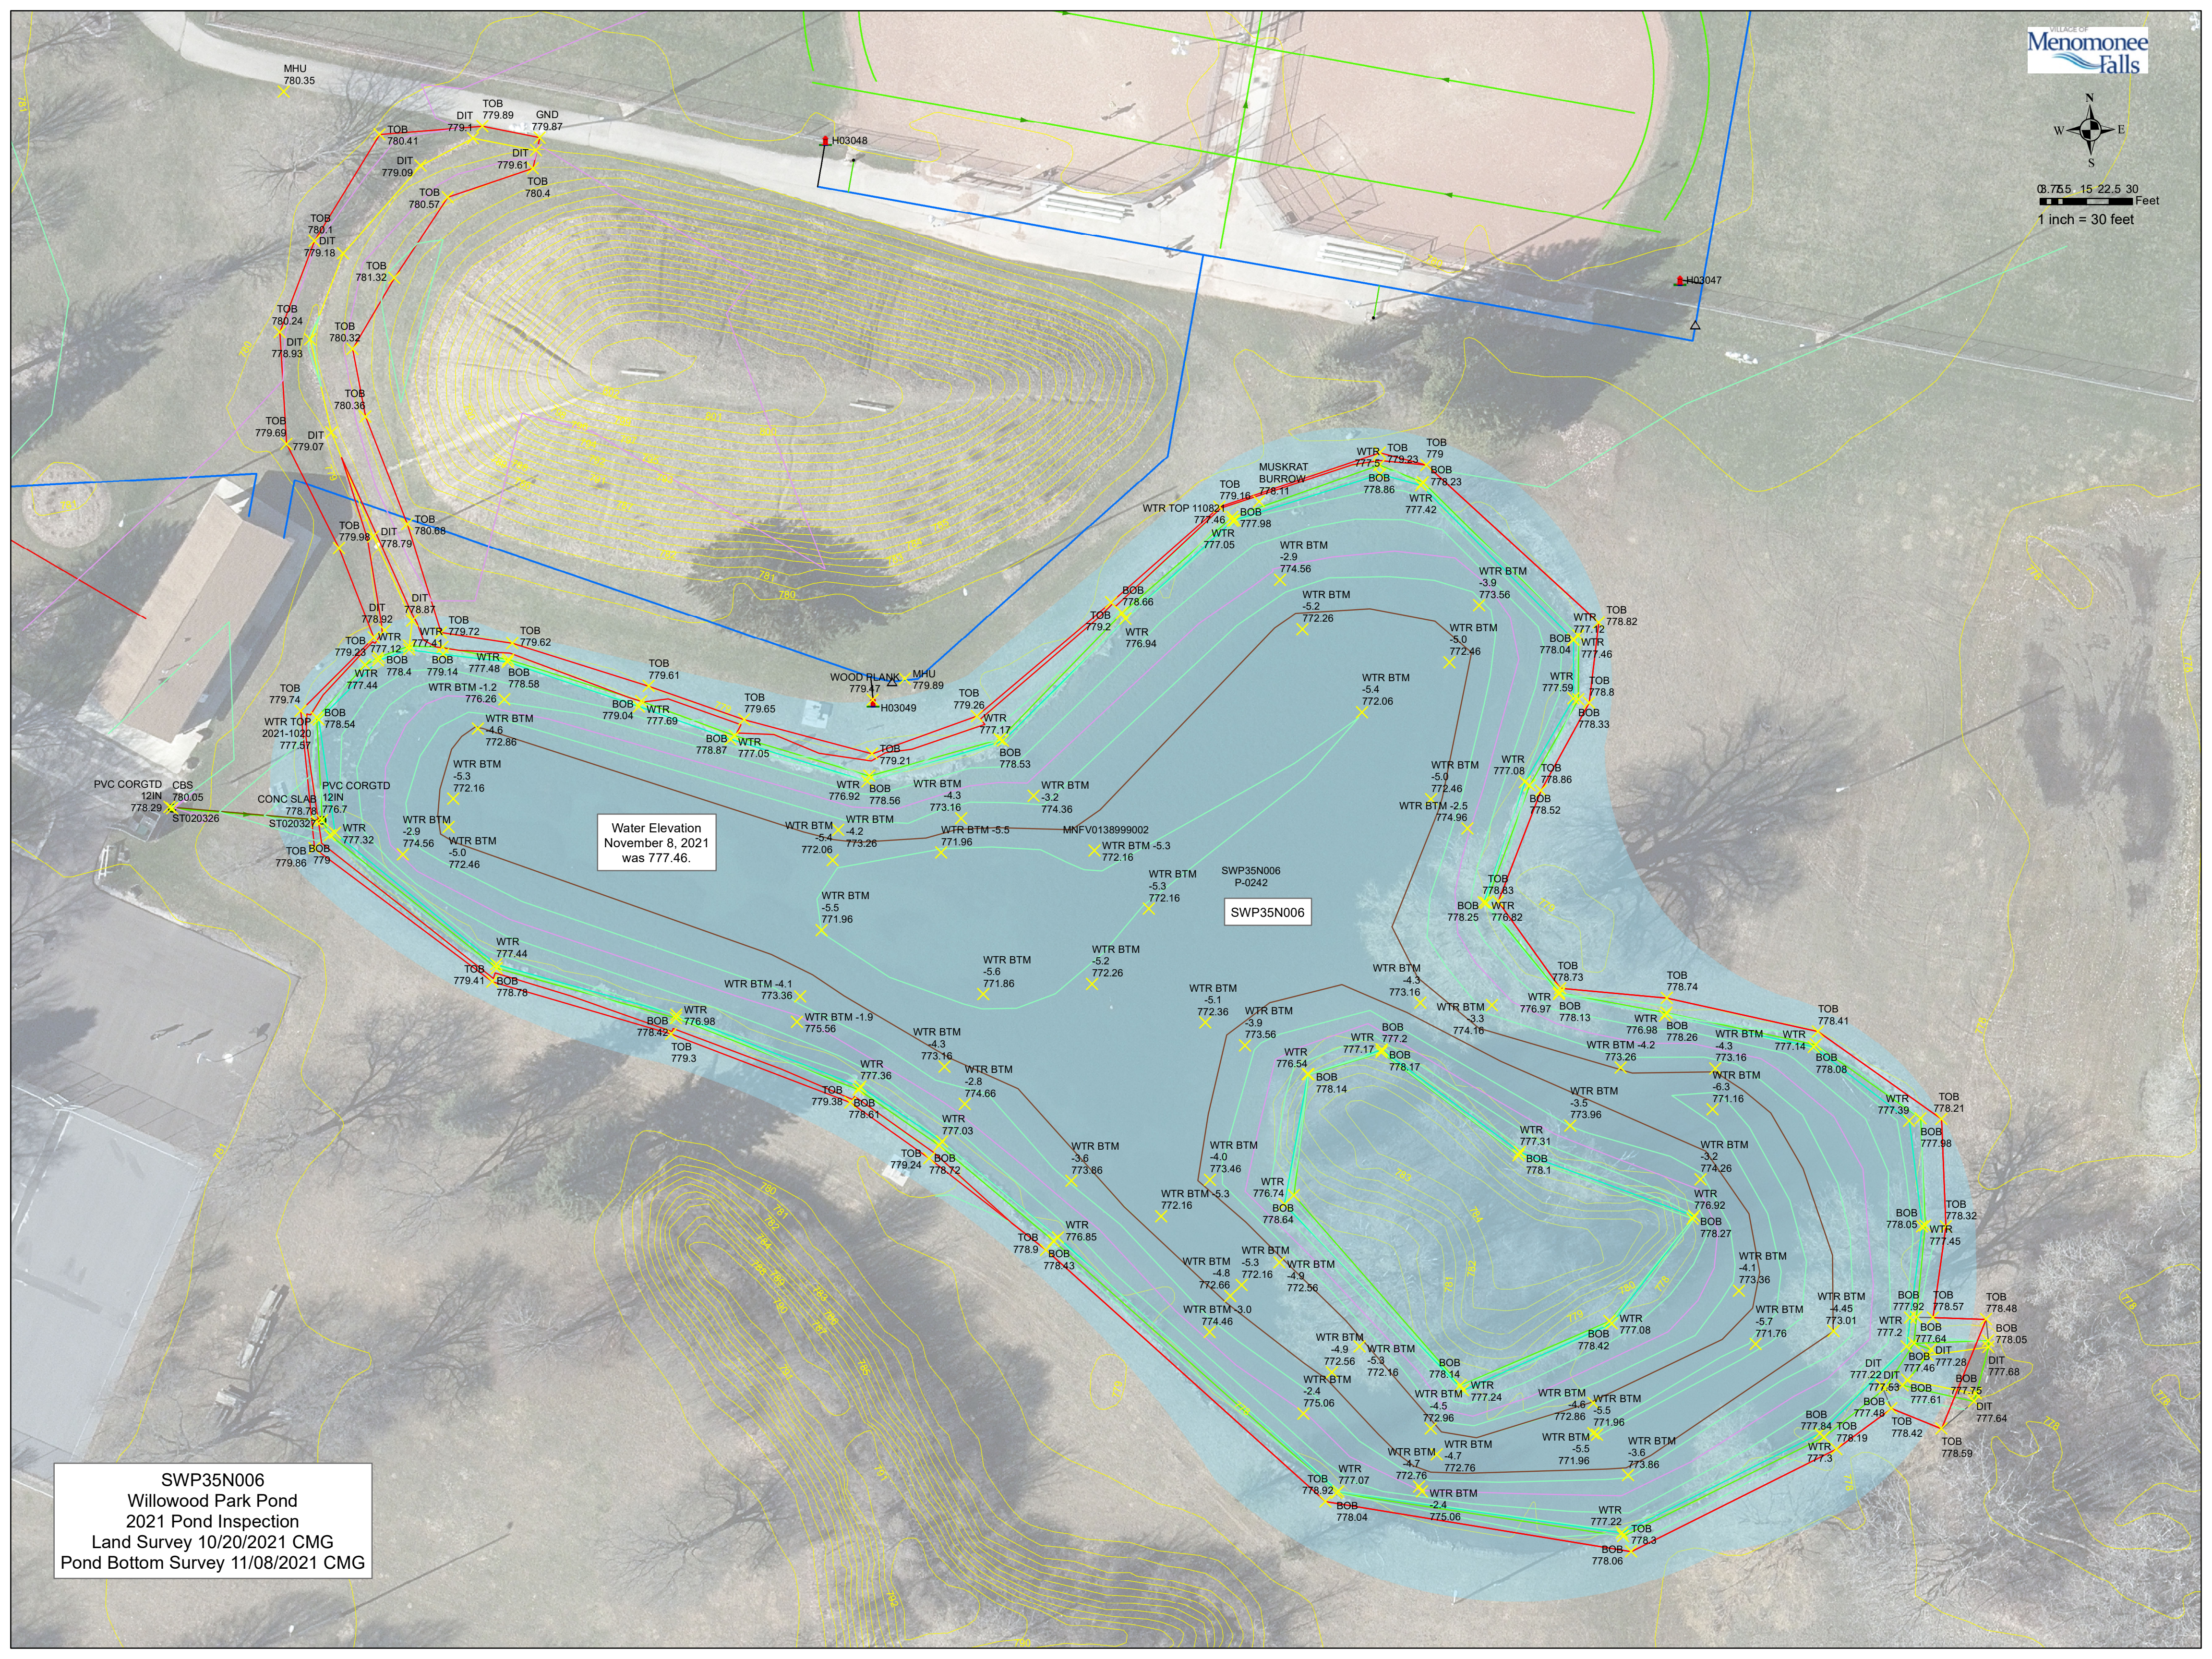

Acre Feet pond storage volume calculations for:

WILLOWOOD PARK POND
SWP35N006

= Entered Value
= Calculated Value
= Description of Elevations Calculated

Year of Inspection: **2021**

Example: $H = H2 - H1$, where $H2 > H1$

H1 =	777.46	Lower Height Elevation in Feet (Pond Bottom for Dry Pond OR Top of Observed Water Level)
H2 =	777.66	Height at Bottom of Spillway (Wet or Dry)
H3 =	778.50	Higher Height Elevation in Feet (Top of Bank Around Pond - Wet or Dry)
H4 =	774.00	Bottom of Wet Pond Elevation in Feet (Wet Ponds Only)
	Sq.Ft.	Acres
Area 1 =	78,126.40	1.7935 Area of H1
		Area 1 = Area at Top of Observed Water Level
Area 2 =	78,494.10	1.8020 Area of H2
		Area 2 = Area at Bottom of Spillway
Area 3 =	87,031.80	1.9980 Area of H3
		Area 3 = Area at Top of Bank
Area 4 =	34,060.70	0.7819 Area of H4
		Area 4 = Area at Bottom of Pond

Equation to determine Volume (AcFt) of pond storage capacity from

Top of Water to Bottom of Spillway:

$$V = (((H2-H1)/3)(A1+A2 + (\sqrt{A1+A2})))$$

	Feet		Acres		Acres
V=	$((H2-H1)/3)$	x	$(A1+A2)$	+	$\sqrt{A1+A2}$
V=	0.0667	x	3.5955	+	1.8962
V=	0.0667	x	5.4917		
V=	0.3661	AcFt			

Equation to determine Volume (AcFt) of pond storage capacity from

Top of Water to Top of Bank at Spillway:

$$V = (((H3-H1)/3)(A1+A3 + (\sqrt{A1+A3})))$$

	Feet		Acres		Acres
V=	$((H3-H1)/3)$	x	$(A1+A3)$	+	$\sqrt{A1+A3}$
V=	0.3467	x	3.7915	+	1.9472
V=	0.3467	x	5.7387		
V=	1.9894	AcFt			

Equation to determine Volume (AcFt) of pond storage capacity from

Bottom of Pond to Top of Water:

$$V = (((H1-H4)/3)(A1+A4 + (\sqrt{A1+A4})))$$

	Feet		Acres		Acres
V=	$((H1-H4)/3)$	x	$(A1+A4)$	+	$\sqrt{A1+A4}$
V=	1.1533	x	2.5755	+	1.6048
V=	1.1533	x	4.1803		
V=	4.8213	AcFt			

Equation to determine Volume (AcFt) of pond storage capacity from

Bottom of Pond to Top of Bank at Spillway:

$$V = (((H3-H4)/3)(A3+A4 + (\sqrt{A3+A4})))$$

	Feet		Acres		Acres
V=	$((H3-H4)/3)$	x	$(A3+A4)$	+	$\sqrt{A3+A4}$
V=	1.5000	x	2.7799	+	1.6673
V=	1.5000	x	4.4472		
V=	6.6708	AcFt			