



Village of Menomonee Falls
W156 N8480 Pilgrim Road
Menomonee Falls, WI 53051-3140
Telephone: (262) 532-4200

STORMWATER MANAGEMENT FACILITIES OPERATION AND INSPECTION REPORT

Quarter Section 03 SW Name of Business/Subdivision VILLAGE PARK
Property Tax ID Number 0011146 Address of Property APPLETON AVE &
GARFIELD DR
MENOMONEE FALLS, WI 53051

Dry Pond	<input checked="" type="checkbox"/>	Description: <u>SWP10N001</u> <u>P-0226</u>	Location Of Pond	<u>SW OF AMPITHEATER</u>
Wet Pond	<input type="checkbox"/>			
Other	<input type="checkbox"/>			

Year Pond Constructed 2020 Year of Last Certification N/A

Compliance Verification	Design	Actual	Compliant Yes	Compliant No	Comments (Condition of Structure)
Primary Outlet Pipe					Outlet Pipe Material
Opening Diameter (inches) (ST015376)	12" RCP	12" RCP	Y		IN GOOD CONDITION.
Upstream Invert	833.63	833.87	Y		
Downstream Invert	833.43	833.66	Y		
Length (feet)	20	18.4	Y		
Slope (%)	1.00 %	1.14 %	Y		
Secondary Outlet Pipe	(If Applicable)				Outlet Pipe Material
Opening Diameter (inches)					
Upstream Invert					
Downstream Invert					
Length (feet)					
Slope (%)					
Riser	(If Applicable)				Riser Material
Opening Diameter (inches) (ST017899-ST017900)					
Elevation					
Upper Discharge Control	(If Applicable)				
Opening Diameter (inches)					
Elevation					

Compliance Verification	Design	Actual	Compliant Yes	No	Comments	
Lower Discharge Control	(If Applicable)					
Opening Diameter (inches)						
Elevation						
Other (Description)						
Opening Type and Size (inches)						
Elevation						
Emergency Spillway						
Elevation	835.80	836.1	Y	-	PROPOSED DRAINAGE MAP (11/13/2019)	
Length of spillway (feet)	15.0	15.7	Y	-	SITE UTILITY PLAN (11/13/2019)	
Embankment	Present Yes No		Comments/Maintenance Requirements			
Unauthorized Plantings, trees, or woody vegetation	-	X				
Animal burrows or slope erosion	-	X				
Storm Sewer Outfalls	Type & Size		Location		Comments	
Outfall 1						
Outfall 2						
Outfall 3						
Storage Properties	Design	Actual	Compliant Yes	No	Not Applicable	Equipment Used
Normal Water Elevation (Wet Ponds)	N/A	N/A	-		X	GPS EQUIPMENT: GEOMAX ZENITH35 & CARLSON SURVEYOR2 WITH SURV CE v5.04
Design High Water Elevation	835.96	836.10	Y			
Area at Normal Water Elevation (Ac) (Wet Ponds)	N/A	N/A	-		X	
Area at Design High Water Elevation (Ac)	0.265 AC	0.254 AC	Y			
Active Storage Available (Ac-Ft)*	0.322 ACFT	0.357 ACFT	Y			
Lowest Elevation at Top of Embankment (If Applicable)	837.00	836.63	Y			
Average Elevation at Top of Embankment (If Applicable)	837.00	837.00	Y			
Maximum Bottom Elevation	833.63	833.87	Y			
Average Pond Bottom Elevation	835.00	835.00	Y			
Pond Bottom Area (Ac)	0.027 AC	0.028 AC	Y			
Maximum Pond Depth	3.37 FT	3.13 FT	Y			ELEVATIONS TO VARY SLIGHTLY FROM YEAR TO YEAR DUE TO GPS TECHNOLOGY
Average Pond Depth	2.0 FT	2.0 FT	Y			
Average Permanent Pool Depth (Wet Ponds)	N/A	N/A	-		X	

*To Determine Active Storage $V = ((H/3)(A1 + A2 + ((A1 + A2)^{(1/2)})))$

Wet Ponds Use $H = \text{Height of Section}$, $A1 = \text{area at normal water elevation}$, $A2 = \text{area at top section}$

Dry Ponds Use $H = \text{Height of Section}$, $A1 = \text{pond bottom area}$, $A2 = \text{area at top section}$

Village Park Amphitheater Retention Basin - SWP10N001

Overview

Looking N/NW



Looking E/NE



Outlet ST01380 & Spillway



Village Park Amphitheater Retention Basin - SWP10N001

Repairs Needed (11/08/21)

None

Place Photograph of Pond


Place Photograph of Pond


Inspection Firm:	VILLAGE OF MENOMONEE FALLS	Inspector Name:	CHRISTOPHER M. GARIEPY
Phone Number:	(262) 532-4411	Inspection Date:	October 20, 2021
Address:	VILLAGE OF MENOMONEE FALLS W156N8480 PILGRIM RD MENOMONEE FALLS, WI 53051		


Certifying

Professional Name: THOMAS M. HOFFMAN, P.E.
Phone Number: (262) 532-4415

Date:
4/14/2022

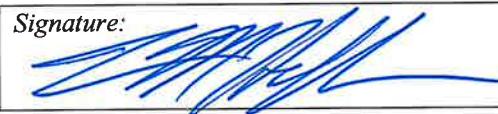Signature: 

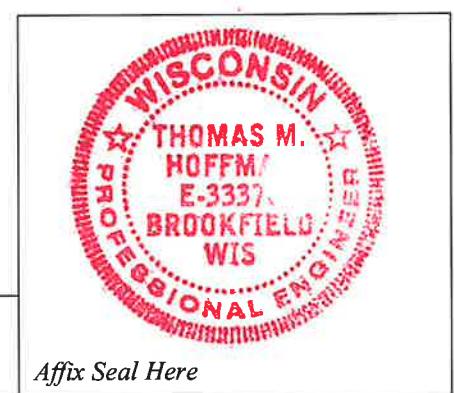

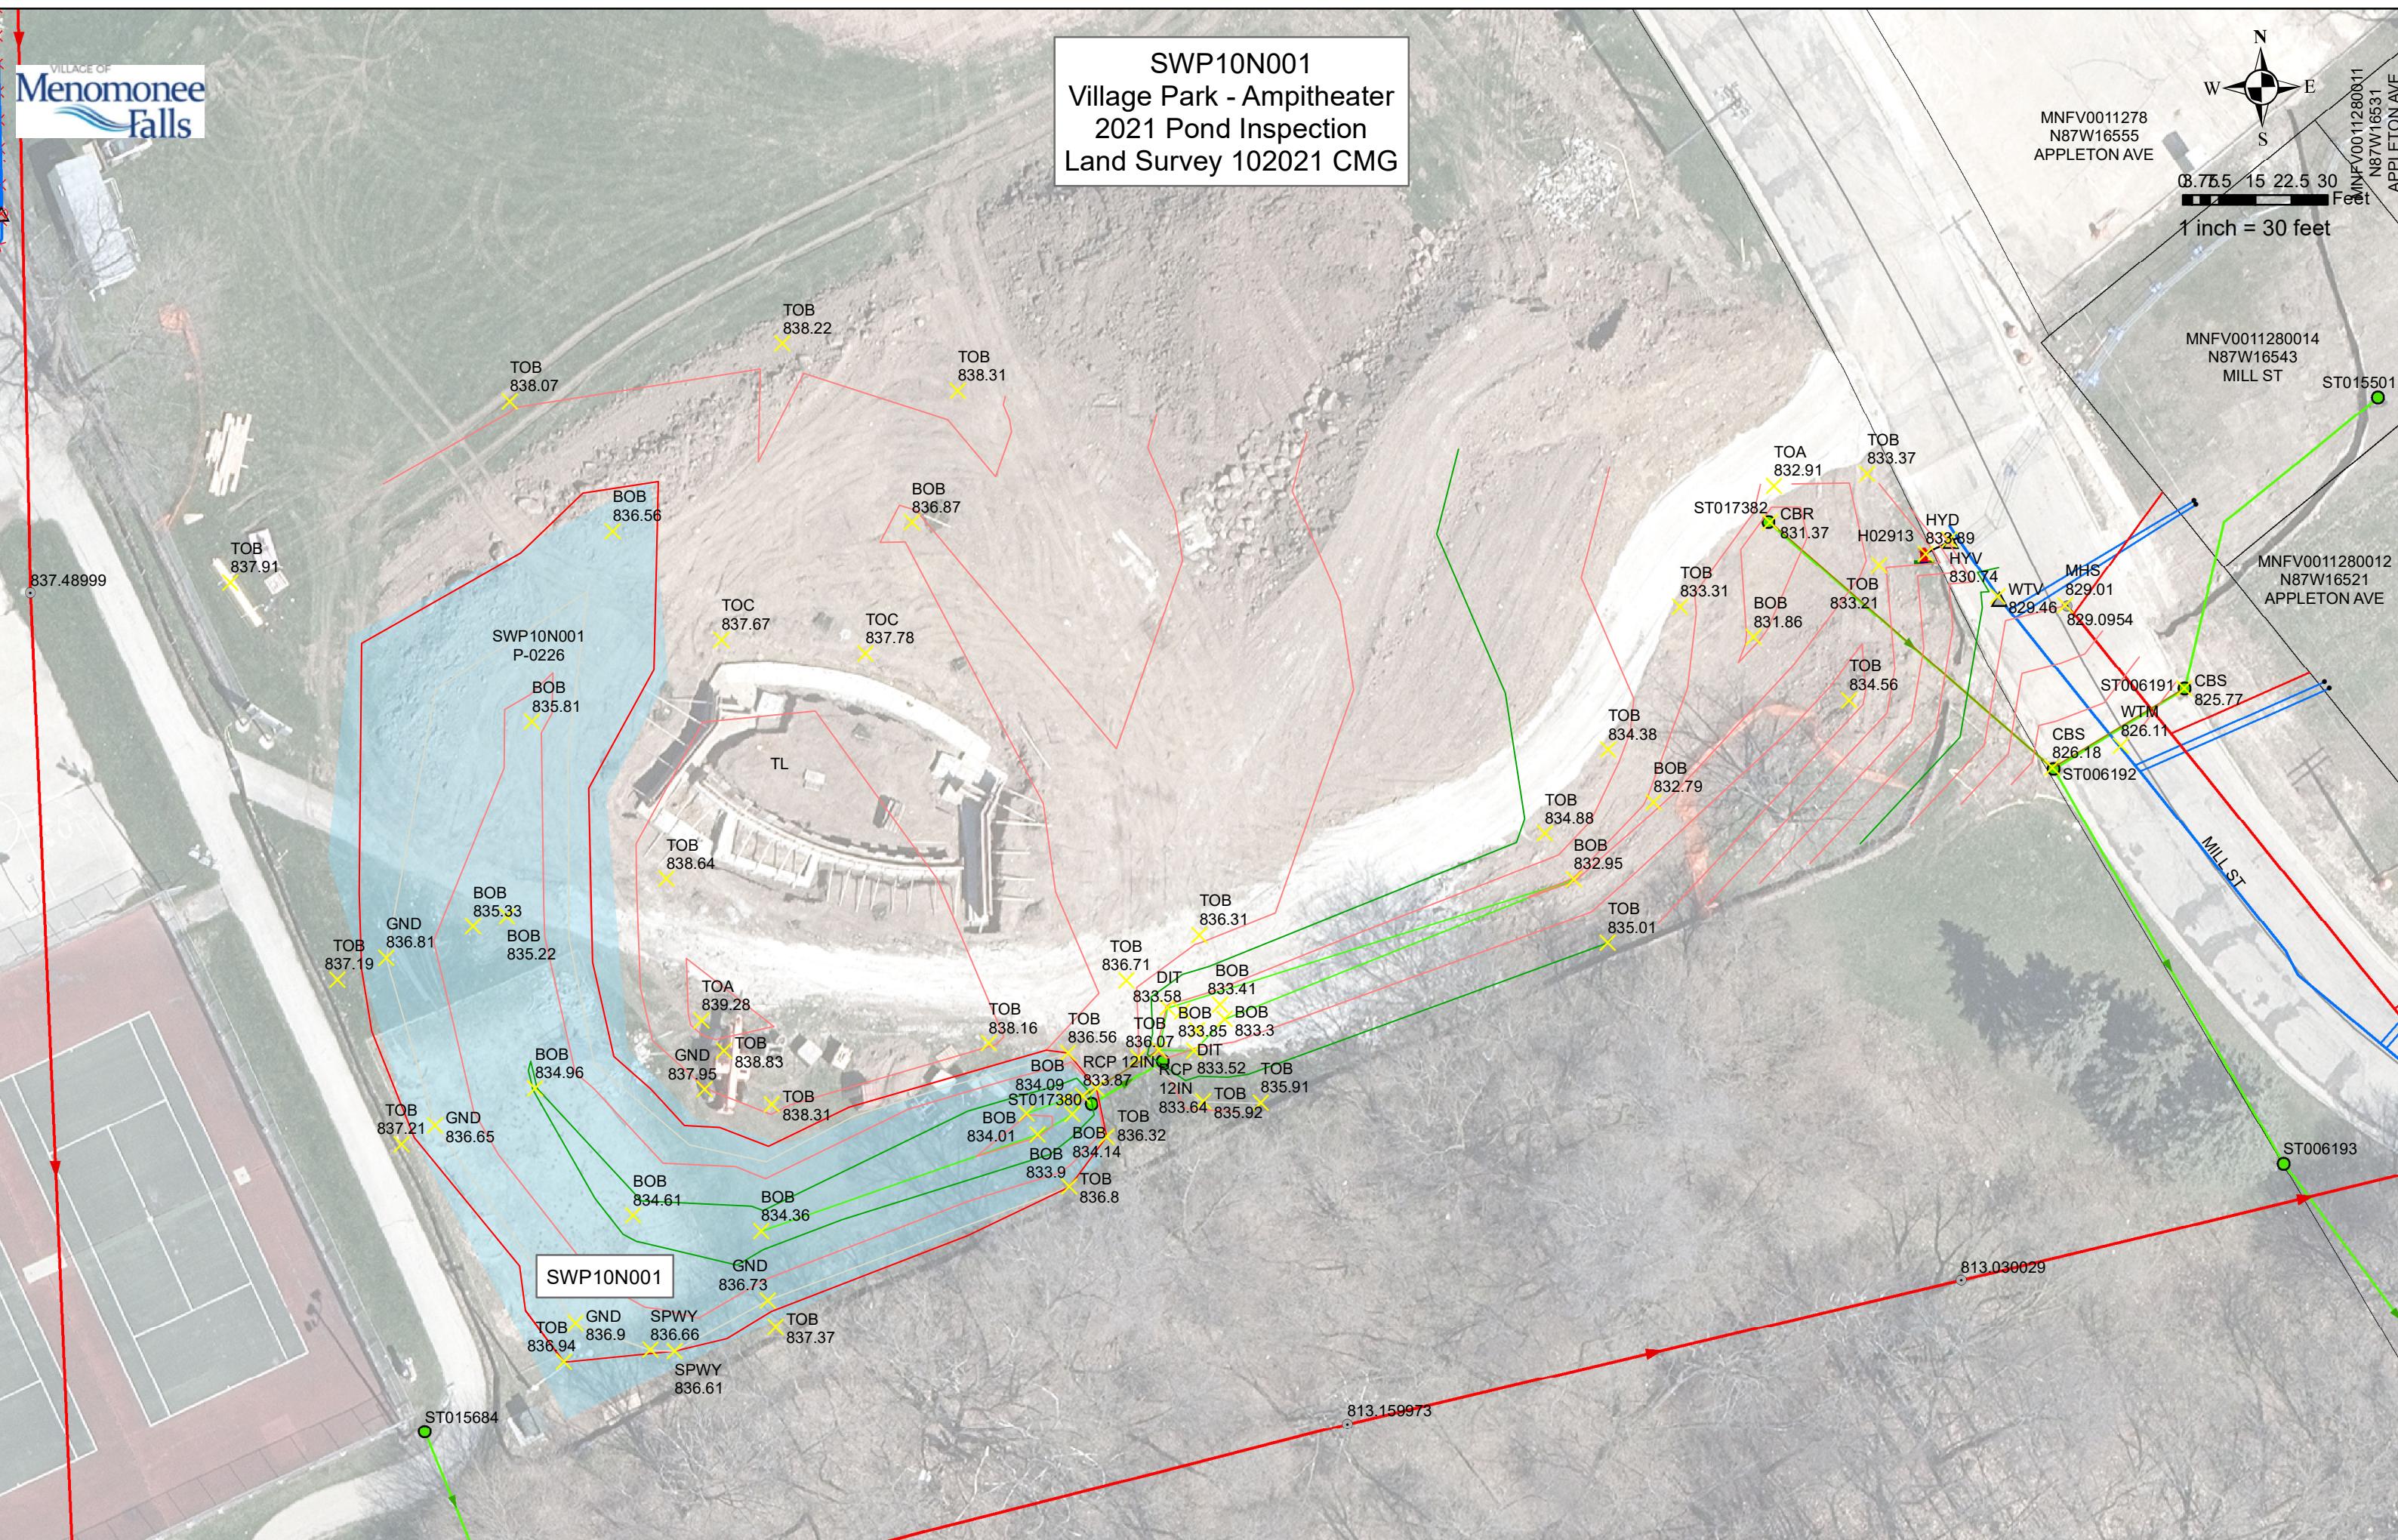

Acre Feet pond storage volume calculations for:

Village Park Retention Pond
SWP10N001

= Entered Value
= Calculated Value
= Description of Elevations Calculated

Year of Inspection: 2021

Example: $H = H2 - H1$, where $H2 > H1$

H1 =	835.00	Lower Height Elevation in Feet (Pond Bottom for Dry Pond OR Top of Observed Water Level)
H2 =	836.63	Height at Bottom of Spillway (Wet or Dry)
H3 =	837.00	Higher Height Elevation in Feet (Top of Bank Around Pond - Wet or Dry)
H4 =	0.00	Bottom of Wet Pond Elevation in Feet (Wet Ponds Only)
Area 1 =	1,231.00	0.0283 Area of H1
Area 2 =	7,677.70	0.1763 Area of H2
Area 3 =	11,073.70	0.2542 Area of H2
Area 4 =	-	0.0000 Area of H3
		Area 1 = Area at Pond Bottom for Dry Pond OR Top of Observed Water Level
		Area 2 = Area at Bottom of Spillway
		Area 3 = Area at Top of Bank
		Area 4 = Area at Bottom of Pond (Wet Ponds Only)

Equation to determine Volume (AcFt) of pond storage capacity from
Bottom of Dry Pond to Bottom of Spillway:

$$V = ((H2 - H1)/3)(A1 + A2 + \sqrt{A1 + A2})$$

Feet	Acres	Acres
$V = ((H2 - H1)/3) \times (A1 + A2) + \sqrt{A1 + A2}$		
0.5433	0.2045	0.4522
0.5433	0.6567	
V = 0.3568 AcFt		

sf acres
11546 **0.2651**

6115sf

Equation to determine Volume (AcFt) of pond storage capacity from
Bottom of Dry Pond to Top of Bank at Spillway:

$$V = ((H3 - H1)/3)(A1 + A3 + \sqrt{A1 + A3})$$

Feet	Acres	Acres
$V = ((H3 - H1)/3) \times (A1 + A3) + \sqrt{A1 + A3}$		
0.6667	0.2825	0.5315
0.6667	0.8140	
V = 0.5426 AcFt		

Equation to determine Volume (AcFt) of pond storage capacity from
Bottom of Pond to Top of Water:

$$V = ((H1 - H4)/3)(A1 + A4 + \sqrt{A1 + A4})$$

Feet	Acres	Acres
$V = ((H1 - H4)/3) \times (A1 + A4) + \sqrt{A1 + A4}$		
278.3333	0.0283	0.1681
278.3333	0.1964	
V = 54.6554 AcFt		

Equation to determine Volume (AcFt) of pond storage capacity from
Bottom of Pond to Top of Bank at Spillway:

$$V = ((H3 - H4)/3)(A3 + A4 + \sqrt{A3 + A4})$$

Feet	Acres	Acres
$V = ((H3 - H4)/3) \times (A3 + A4) + \sqrt{A3 + A4}$		
279.0000	0.2542	0.5042
279.0000	0.7584	
V = 211.5983 AcFt		