



Village of Menomonee Falls
W156 N8480 Pilgrim Road
Menomonee Falls, WI 53051-3140
Telephone: (262) 532-4200

STORMWATER MANAGEMENT FACILITIES OPERATION AND INSPECTION REPORT

Quarter Section	15 NE	Name of Business/Subdivision	HUNTER'S RIDGE ESTATES
Property Tax ID Number	0057158	Address of Property	

Dry Pond	X
Wet Pond	
Other	

Description: <u>SWP15N005</u>	Location Of <u>SOUTHWEST OF</u>
<u>P-0065B, U-0261</u>	<u>PILGRIM RD &</u>
	<u>COUNTRYSIDE DR</u>

Year Pond Constructed 1987 Year of Last Certification 2018

Compliance Verification	Design (Non-AsBuilt)	Actual (GPS)	Compliant Yes No		Comments (Condition of Structure)
Primary Outlet Pipe (ST001974)					Outlet Pipe Material
Opening Diameter (inches)	18” RCP	18” RCP	Y	-	18” RCP IN GOOD CONDITION, REPAIR GAP/SMALL SINK HOLE @ JOINT
Upstream Invert	837.50	837.53	Y	-	
Downstream Invert	837.50	837.35	Y	-	
Length (feet)	54.0 FT	55.4 FT	Y	-	
Slope (%)	0.0024’/,	0.0032’/,	Y	-	
Secondary Outlet Pipe	N/A				Outlet Pipe Material
Opening Diameter (inches) (ST001976)	15” RCP	15” RCP	Y	-	15” RCP IN GOOD CONDITION
Upstream Invert	837.50	837.30	Y	-	
Downstream Invert	837.50	837.20	Y	-	
Length (feet)	6.0 FT	6.0 FT	Y	-	
Slope (%)	0.0000’/,	0.0167’/,	Y	-	
Riser	N/A				Riser Material
Opening Diameter (inches) (ST001973)		24”x24”	Y	-	GOOD CONDITION
Elevation		841.00	Y	-	
Upper Discharge Control	N/A				
Opening Diameter (inches)					
Elevation					

Compliance Verification	Design	Actual	Compliant Yes No		Comments	
Lower Discharge Control	N/A					
Opening Diameter (inches)						
Elevation						
Other (Description)	N/A					
Opening Type and Size (inches)						
Elevation						
Emergency Spillway						
Elevation	842.00	841.50	Y			
Length of spillway (feet)	10.0 FT	4.0 FT	Y			
Embankment	Present Yes No		Comments/Maintenance Requirements			
Unauthorized Plantings, trees, or woody vegetation	-	N	REPAIR JOINT GAP/SINK HOLE @ OUTLET PIPE			
Animal burrows or slope erosion or hole	Y	-				
Storm Sewer Outfalls	Type & Size		Location		Comments	
Outfall 1 (ST006016)	RCP - 36"		NORTHWESTERLY EMBANKMENT		RCP IN GOOD CONDITION	
Outfall 2						
Outfall 3						
Storage Properties	Design (NON-ASBUILT)	Actual (GPS)	Compliant Yes No		Not Applicable	Equipment Used
Normal Water Elevation (Wet Ponds)	-	-	-	-	N/A	GPS EQUIPMENT: GEOMAX ZENITH35 & CARLSON SURVEYOR2 WITH SURV CE v5.04
Design High Water Elevation	842.00	841.50	Y			
Area at Normal Water Elevation (Ac) (Wet Ponds)	-	-	-	-	N/A	
Area at Design High Water Elevation (Ac)	-	0.638 AC	Y			
Active Storage Available (Ac-Ft)*	-	11.856 ACFT	Y			
Lowest Elevation at Top of Embankment (If Applicable)	842.00	843.28	Y			
Average Elevation at Top of Embankment (If Applicable)	844.00	843.70	Y			
Maximum Bottom Elevation	842.00	837.49	Y			
Average Pond Bottom Elevation	838.50	838.50	Y			
Pond Bottom Area (Ac)	-	0.267 AC	Y			
Maximum Pond Depth	4.5 FT	4.01 FT	Y			
Average Pond Depth	4.0 FT	3.00 FT	Y			
Average Permanent Pool Depth (Wet Ponds)	-	-	-	-	N/A	

*To Determine Active Storage $V = \left(\left(\frac{H}{3} \right) \left(A1 + A2 + \left(\left(A1 + A2 \right)^{\left(\frac{1}{2} \right)} \right) \right) \right)$
 Wet Ponds Use H = Height of Section , $A1$ = area at normal water elevation, $A2$ =area at top section
 Dry Ponds Use H = Height of Section, $A1$ = pond bottom area, $A2$ =area at top section

Hunter's Ridge Estates (Pilgrim Rd & Countryside) Retention Pond - SWP15N005

Overview



ST006016



Hunter's Ridge Estates (Pilgrim Rd & Countryside)
Retention Pond - SWP15N005

ST001973, ST001974, & Emergency Spillway




Emergency Spillway Inlet ST001976 & Manhole ST001975



Hunter's Ridge Estates (Pilgrim Rd & Countryside) Retention Pond - SWP15N005

Repairs Needed (11/2023)


- 1) Fix top of RCP
- 2) Fill Sink Hole

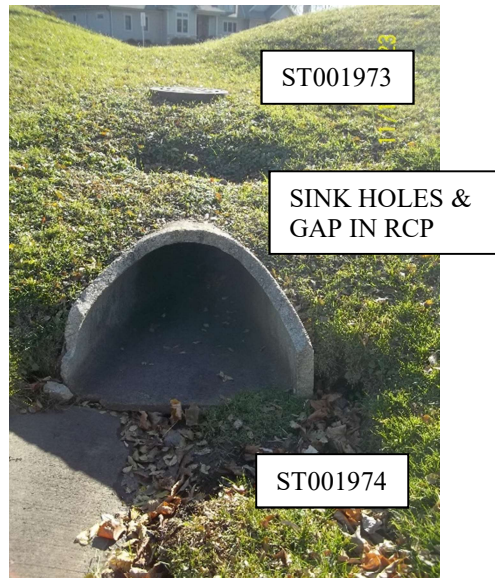


<i>Sketch Outlet</i>	<i>Place Photograph of Pond</i>
	<i>Place Photograph of Pond</i>

Inspection Firm:	VILLAGE OF MENOMONEE FALLS	Inspector Name :	CHRISTOPHER M GARIEPY
Phone Number:	262-532-4411	Inspection Date:	11/15/2023
Address:	W156N8480 PILGRIM RD MENOMONEE FALLS, WI 53051		

Certifying	THOMAS M. HOFFMAN
Professional Name:	
Phone Number:	(262) 532-4415

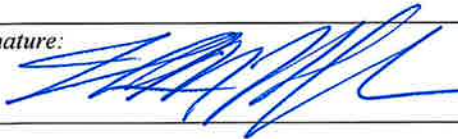Date: 2/26/2024	Signature: 
--------------------	---

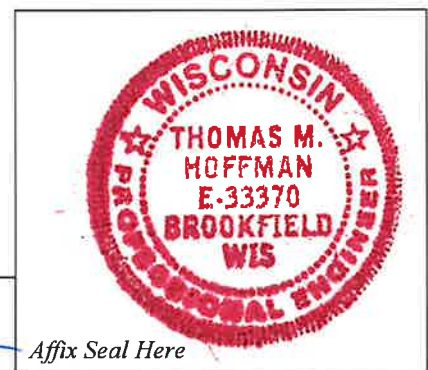

Acre Feet pond storage volume calculations for:

Hunter's Ridge Estates on Countryside Dr
SWP15N005

= Entered Value
= Calculated Value
= Description of Elevations Calculated

Year of Inspection: 2023

Example: $H = H2 - H1$, where $H2 > H1$

H1 =	<u>838.50</u>	Lower Height Elevation in Feet (Pond Bottom for Dry Pond OR Top of Observed Water Level)
H2 =	<u>841.50</u>	Height at Bottom of Spillway (Wet or Dry)
H3 =	<u>843.45</u>	Higher Height Elevation in Feet (Top of Bank Around Pond - Wet or Dry)
H4 =	<u>0.00</u>	Bottom of Wet Pond Elevation in Feet (Wet Ponds Only)
	Sq.Ft.	Acres
Area 1 =	<u>11,609.20</u>	<u>0.2665</u> Area of H1
		Area 1 = Area at Pond Bottom for Dry Pond OR Top of Observed Water Level
Area 2 =	<u>27,810.40</u>	<u>0.6384</u> Area of H2
		Area 2 = Area at Bottom of Spillway
Area 3 =	<u>37,233.10</u>	<u>0.8548</u> Area of H2
		Area 3 = Area at Top of Bank
Area 4 =	-	<u>0.0000</u> Area of H3
		Area 4 = Area at Bottom of Pond (Wet Ponds Only)

Equation to determine Volume (AcFt) of pond storage capacity from
Bottom of Dry Pond to Bottom of Spillway:

$$V = (((H2-H1)/3)(A1+A2 + (\sqrt{A1+A2})))$$

	Feet		Acres		Acres
V=	$((H2-H1)/3)$	x	$(A1+A2)$	+	$\sqrt{A1+A2}$
V=	1.0000	x	0.9049	+	0.9513
V=	1.0000	x	1.8562		
V=	1.8562	AcFt			

Equation to determine Volume (AcFt) of pond storage capacity from
Bottom of Dry Pond to Top of Bank at Spillway:

$$V = (((H3-H1)/3)(A1+A3 + (\sqrt{A1+A3})))$$

	Feet		Acres		Acres
V=	$((H3-H1)/3)$	x	$(A1+A3)$	+	$\sqrt{A1+A3}$
V=	1.6500	x	1.1213	+	1.0589
V=	1.6500	x	2.1802		
V=	3.5973	AcFt			

Equation to determine Volume (AcFt) of pond storage capacity from
Bottom of Pond to Top of Water:

$$V = (((H1-H4)/3)(A1+A4 + (\sqrt{A1+A4})))$$

	Feet		Acres		Acres
V=	$((H1-H4)/3)$	x	$(A1+A4)$	+	$\sqrt{A1+A4}$
V=	279.5000	x	0.2665	+	0.5162
V=	279.5000	x	0.7828		
V=	218.7806	AcFt			


Equation to determine Volume (AcFt) of pond storage capacity from
Bottom of Pond to Top of Bank at Spillway:

$$V = (((H3-H4)/3)(A3+A4 + (\sqrt{A3+A4})))$$


	Feet		Acres		Acres
V=	$((H3-H4)/3)$	x	$(A3+A4)$	+	$\sqrt{A3+A4}$
V=	281.1500	x	0.8548	+	0.9245
V=	281.1500	x	1.7793		
V=	500.2456	AcFt			




SWP15N005
Pilgrim Rd & Countryside Dr - MNFV0057158
Pond Inspection 2023-1115 CMG

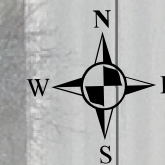

0 7.5 15 22.5 30
Feet
1 inch = 30 feet

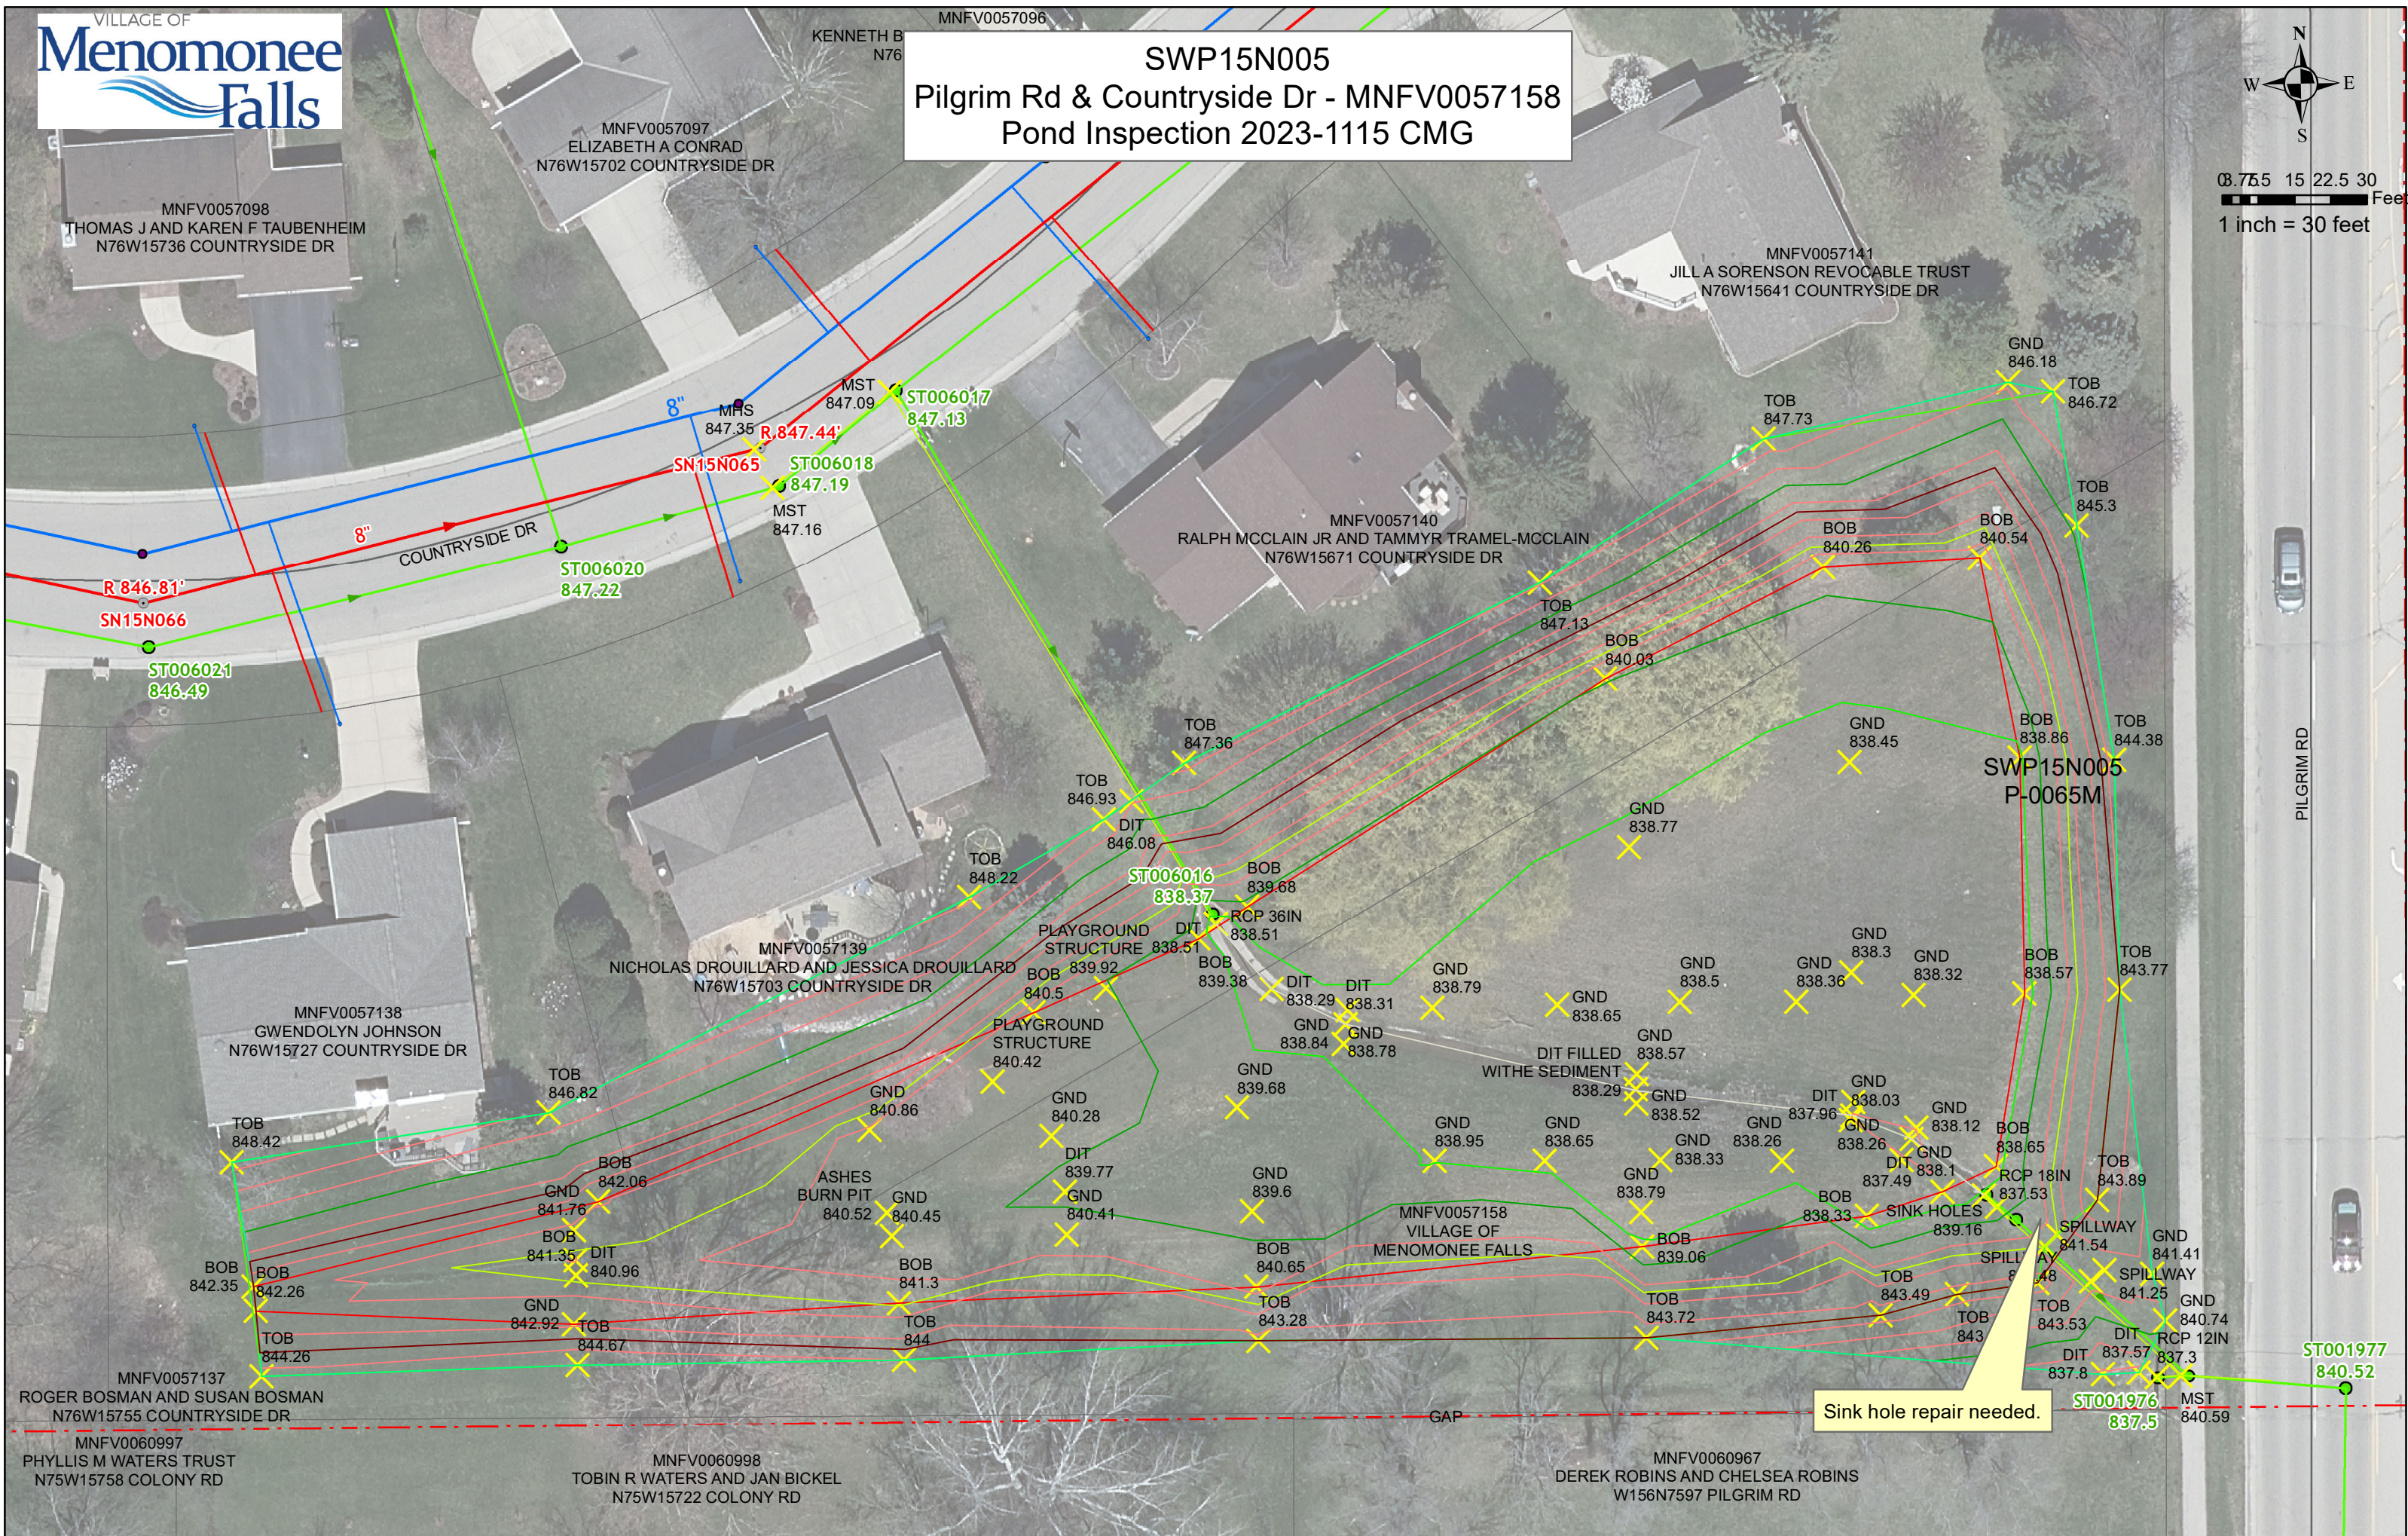

HUNTERS' RIDGE ESTATES

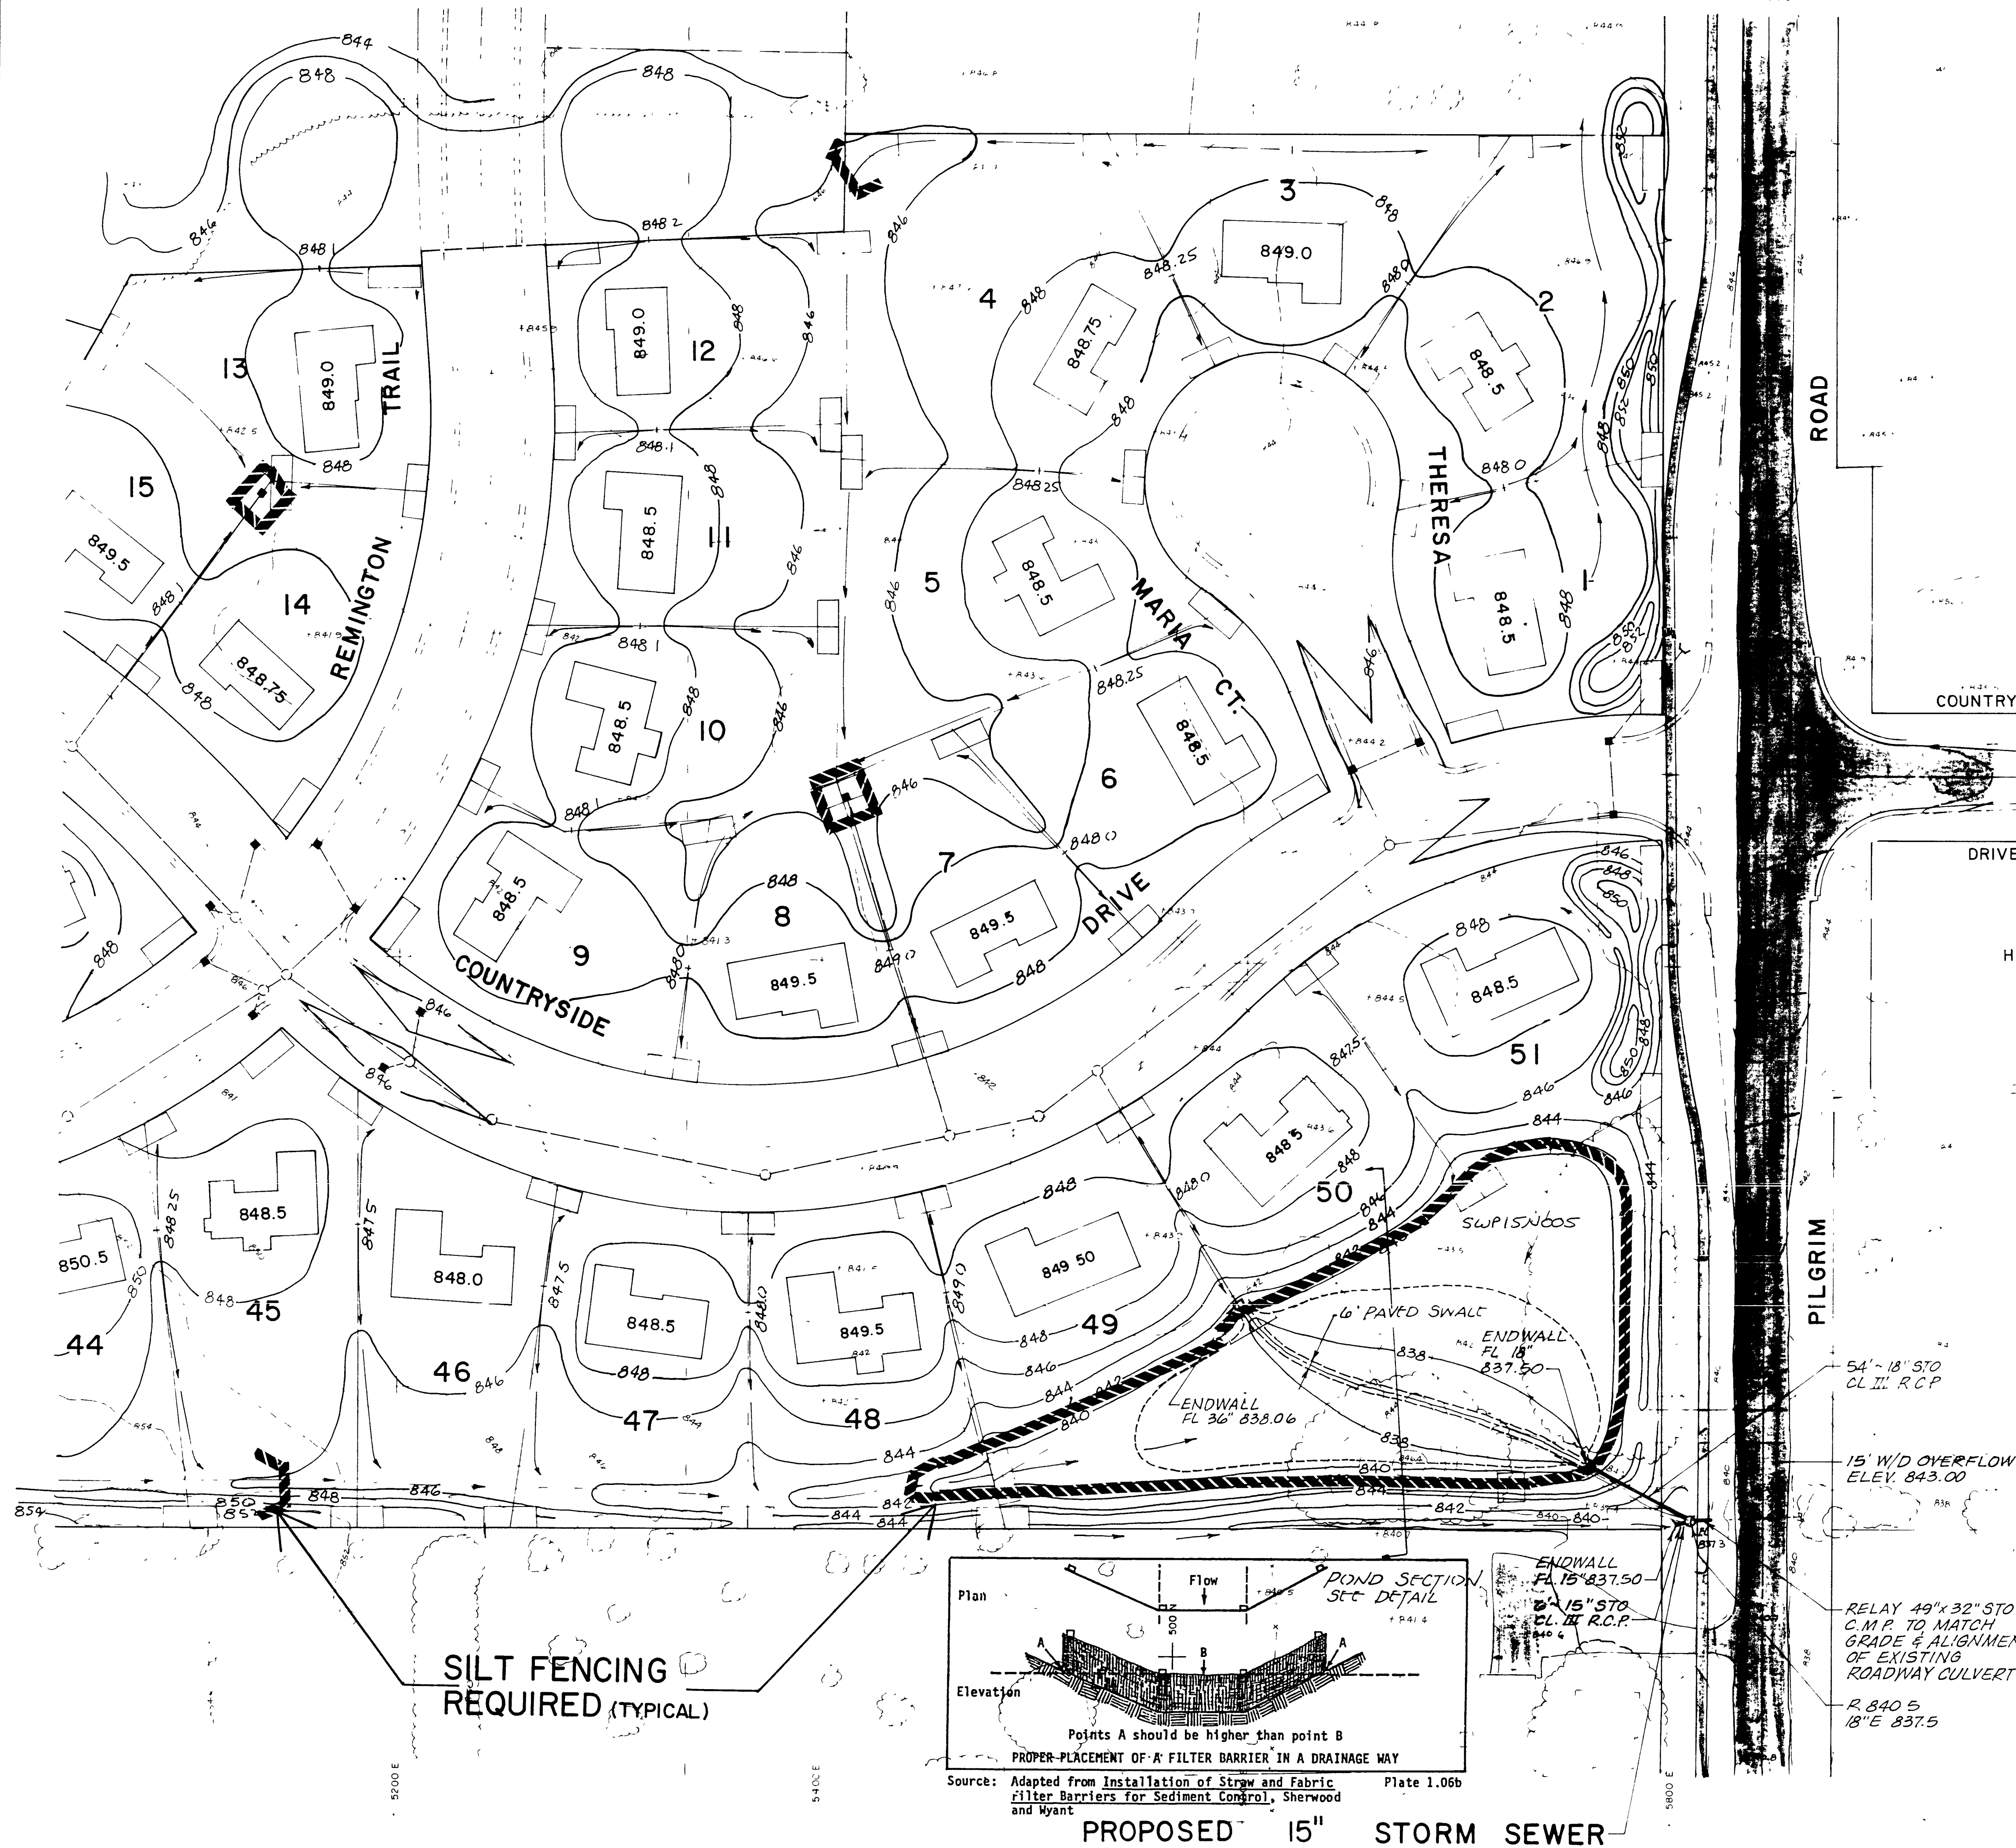

PHEASANT

Materials


1. Synthetic filter fabric shall be a pervious sheet of propylene, nylon, polyester or ethylene yarn and shall be certified by the manufacturer or supplier as conforming to the following requirements:

PHYSICAL PROPERTY	TEST	REQUIREMENTS
Filtering Efficiency	VTM-51	75% (min.)
Tensile Strength at 20% (max.) Elongation*	VTM-52	Extra Strength- 50 lbs./lin. in. (min.) Standard Strength- 30 lbs./lin. in. (min.)
Flow Rate	VTM-51	0.3 gal./sq.ft./min. (min.)

*Requirements reduced by 50 percent after 6 months of installation.


Synthetic filter fabric contain ultraviolet ray inhibitors and stabilizers to provide a minimum of 6 months of expected usable construction life at a temperature range of 0° F to 120° F.

2. Burlap shall be 10 ounce per square yard fabric.
3. Posts for Silt Fences shall be either 4-inch diameter wood or 1.33 pounds per linear foot steel with a minimum length of 5 feet. Steel posts shall have projections for fastening wire to them.
4. Stakes or Filter Barriers shall be 1" x 2" wood (preferred) or equivalent metal with a minimum length of 3 feet.
5. Wire fence reinforcement for silt fences using standard strength filter cloth shall be a minimum of 42 inches in height, a minimum of 14 gauge and shall have a maximum mesh spacing of 6 inches.

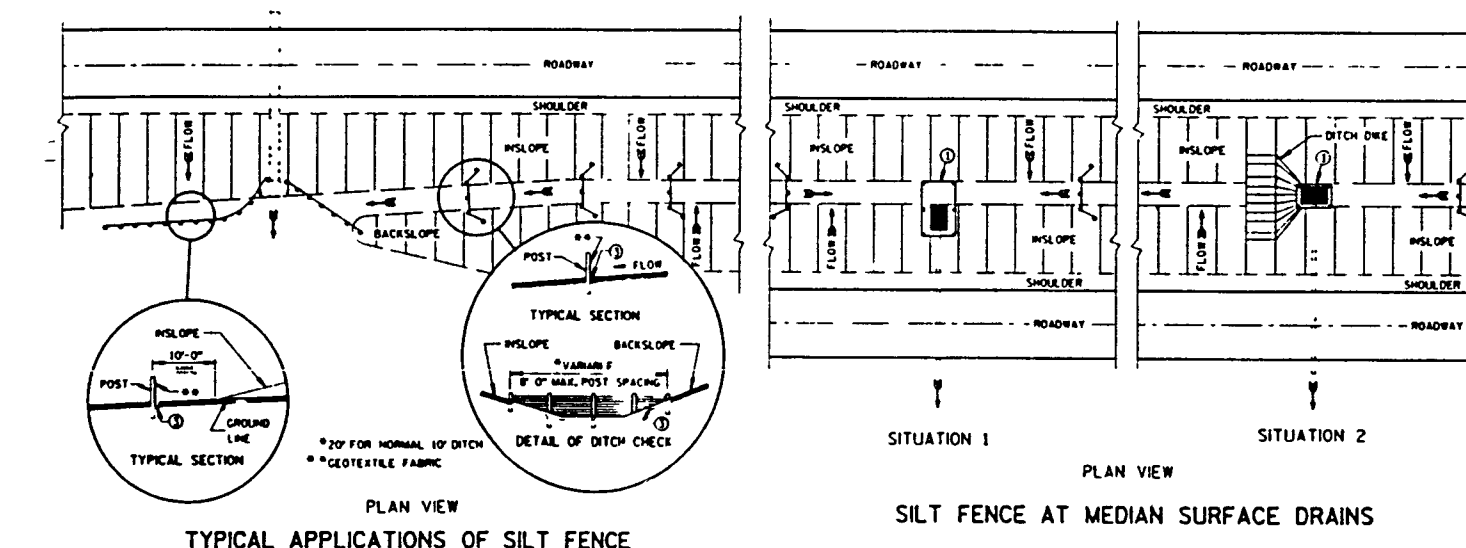


GENERAL NOTES

1. DETAILS OF CONSTRUCTION NOT SHOWN ON THIS DRAWING SHALL CONFORM TO THE STANDARD SPECIFICATIONS FOR HIGHWAY CONSTRUCTION, EDITION 1994, AND THE STANDARD SPECIFICATIONS FOR EROSION CONTROL, EDITION 1994, AND THE STANDARD SPECIFICATIONS FOR EROSION CONTROL, EDITION 1994, AND THE STANDARD SPECIFICATIONS FOR EROSION CONTROL, EDITION 1994.
2. THE SILT FENCE SHALL BE CONSTRUCTED IN ACCORDANCE WITH THE STANDARD SPECIFICATIONS FOR EROSION CONTROL, EDITION 1994, AND THE STANDARD SPECIFICATIONS FOR EROSION CONTROL, EDITION 1994, AND THE STANDARD SPECIFICATIONS FOR EROSION CONTROL, EDITION 1994.
3. THE SILT FENCE SHALL BE CONSTRUCTED IN ACCORDANCE WITH THE STANDARD SPECIFICATIONS FOR EROSION CONTROL, EDITION 1994, AND THE STANDARD SPECIFICATIONS FOR EROSION CONTROL, EDITION 1994, AND THE STANDARD SPECIFICATIONS FOR EROSION CONTROL, EDITION 1994.
4. THE SILT FENCE SHALL BE CONSTRUCTED IN ACCORDANCE WITH THE STANDARD SPECIFICATIONS FOR EROSION CONTROL, EDITION 1994, AND THE STANDARD SPECIFICATIONS FOR EROSION CONTROL, EDITION 1994, AND THE STANDARD SPECIFICATIONS FOR EROSION CONTROL, EDITION 1994.
5. THE SILT FENCE SHALL BE CONSTRUCTED IN ACCORDANCE WITH THE STANDARD SPECIFICATIONS FOR EROSION CONTROL, EDITION 1994, AND THE STANDARD SPECIFICATIONS FOR EROSION CONTROL, EDITION 1994, AND THE STANDARD SPECIFICATIONS FOR EROSION CONTROL, EDITION 1994.

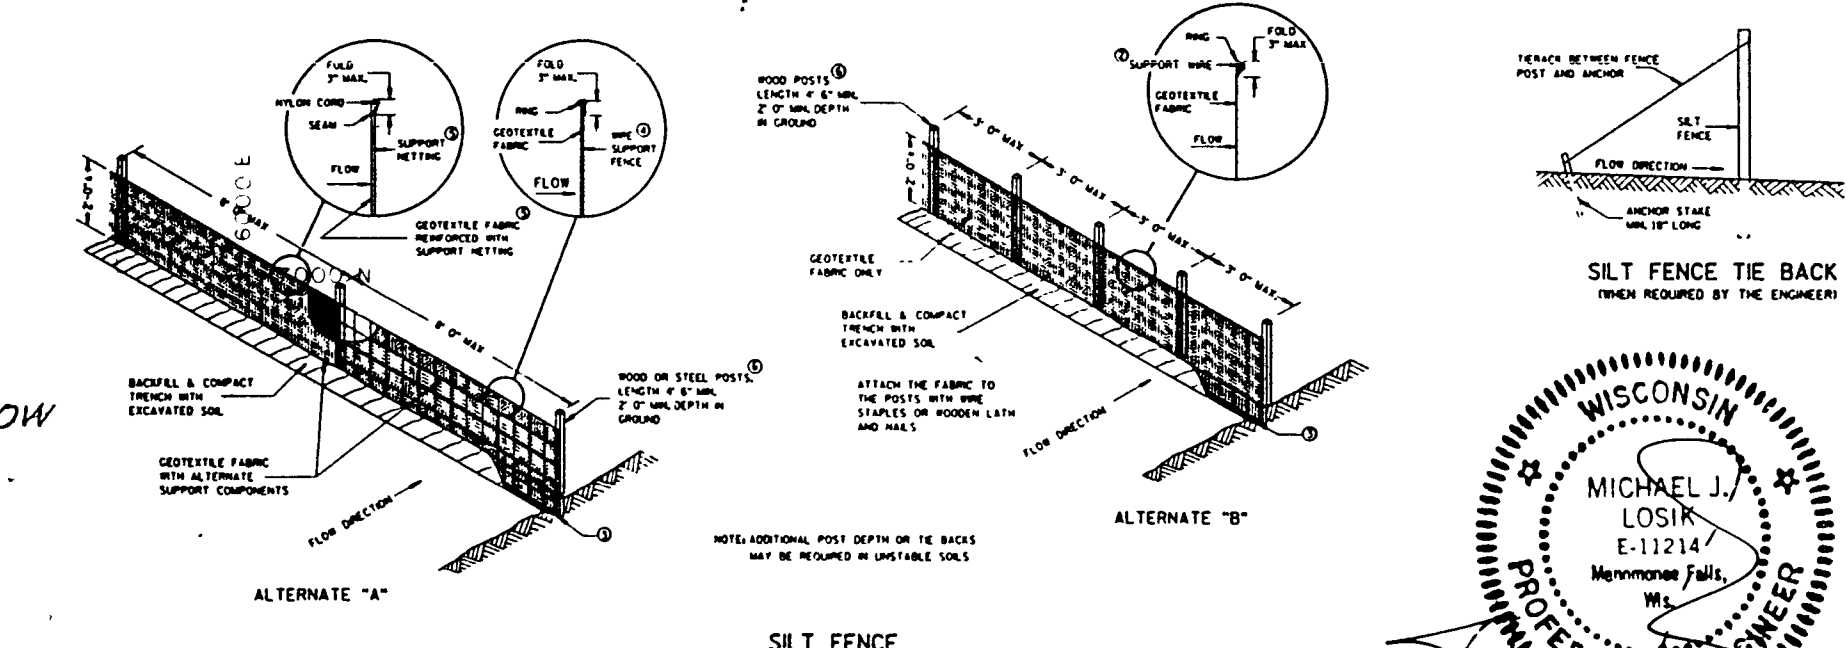


SILT FENCING DETAIL

SILT FENCING REQUIRED (TYPICAL)

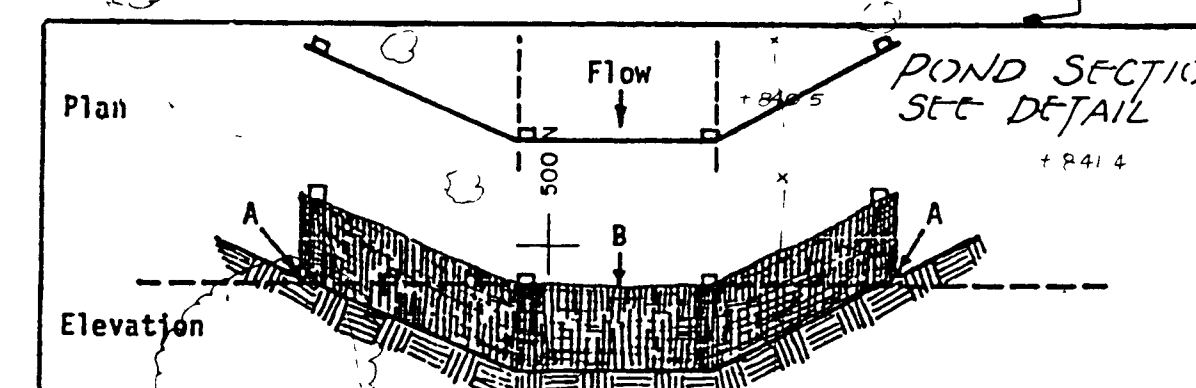

Points A should be higher than point B
PROPER PLACEMENT OF A FILTER BARRIER IN A DRAINAGE WAY

Source: Adapted from Installation of Straw and Fabric Filter Barriers for Sediment Control, Sherwood and Wyant

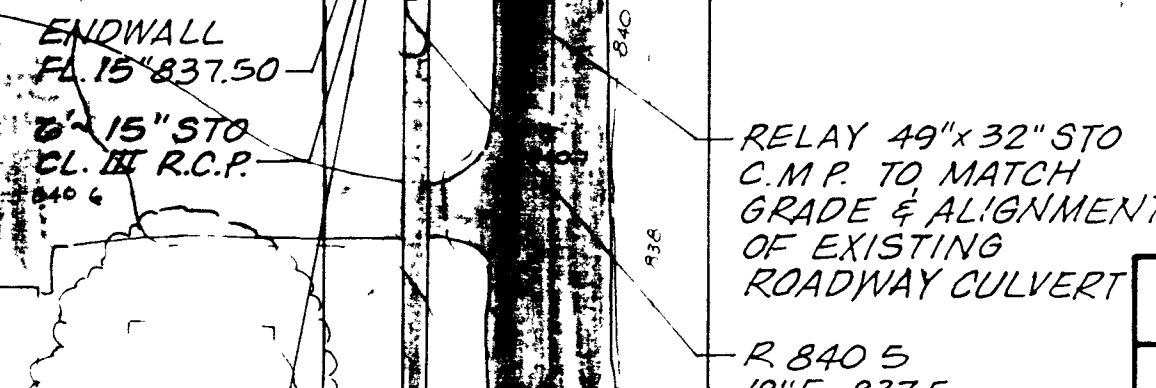

PROPOSED 15" STORM SEWER

REVISIONS	SCALE	DATE
9-2-87	1" = 40'	7-20-87
9-25-87		7-7-87
		8-3-87

EROSION CONTROL PLAN

FOR HUNTERS' RIDGE ESTATES

VILLAGE OF MENOMONEE FALLS, WISCONSIN

MICHAEL J. LOSIK & ASSOC., INC.

240 REGENCY COURT, WAUKESHA, WI 53186

PROFESSIONAL ENGINEERS SHEET 19 OF 22

LAND SURVEYORS