


SWP02s001

SIGMA
GROUP
Single Source. Sound Solutions.
www.thissigmagroup.com
1300 West Canal Street
Milwaukee, WI 53233
Phone: 414-643-4200
Fax: 414-643-4210




Harley Davidson Motor Company
Pilgrim Road Facility
Menomonee Falls, Wisconsin

Topographic Survey
Pond I.D. SWP02s001

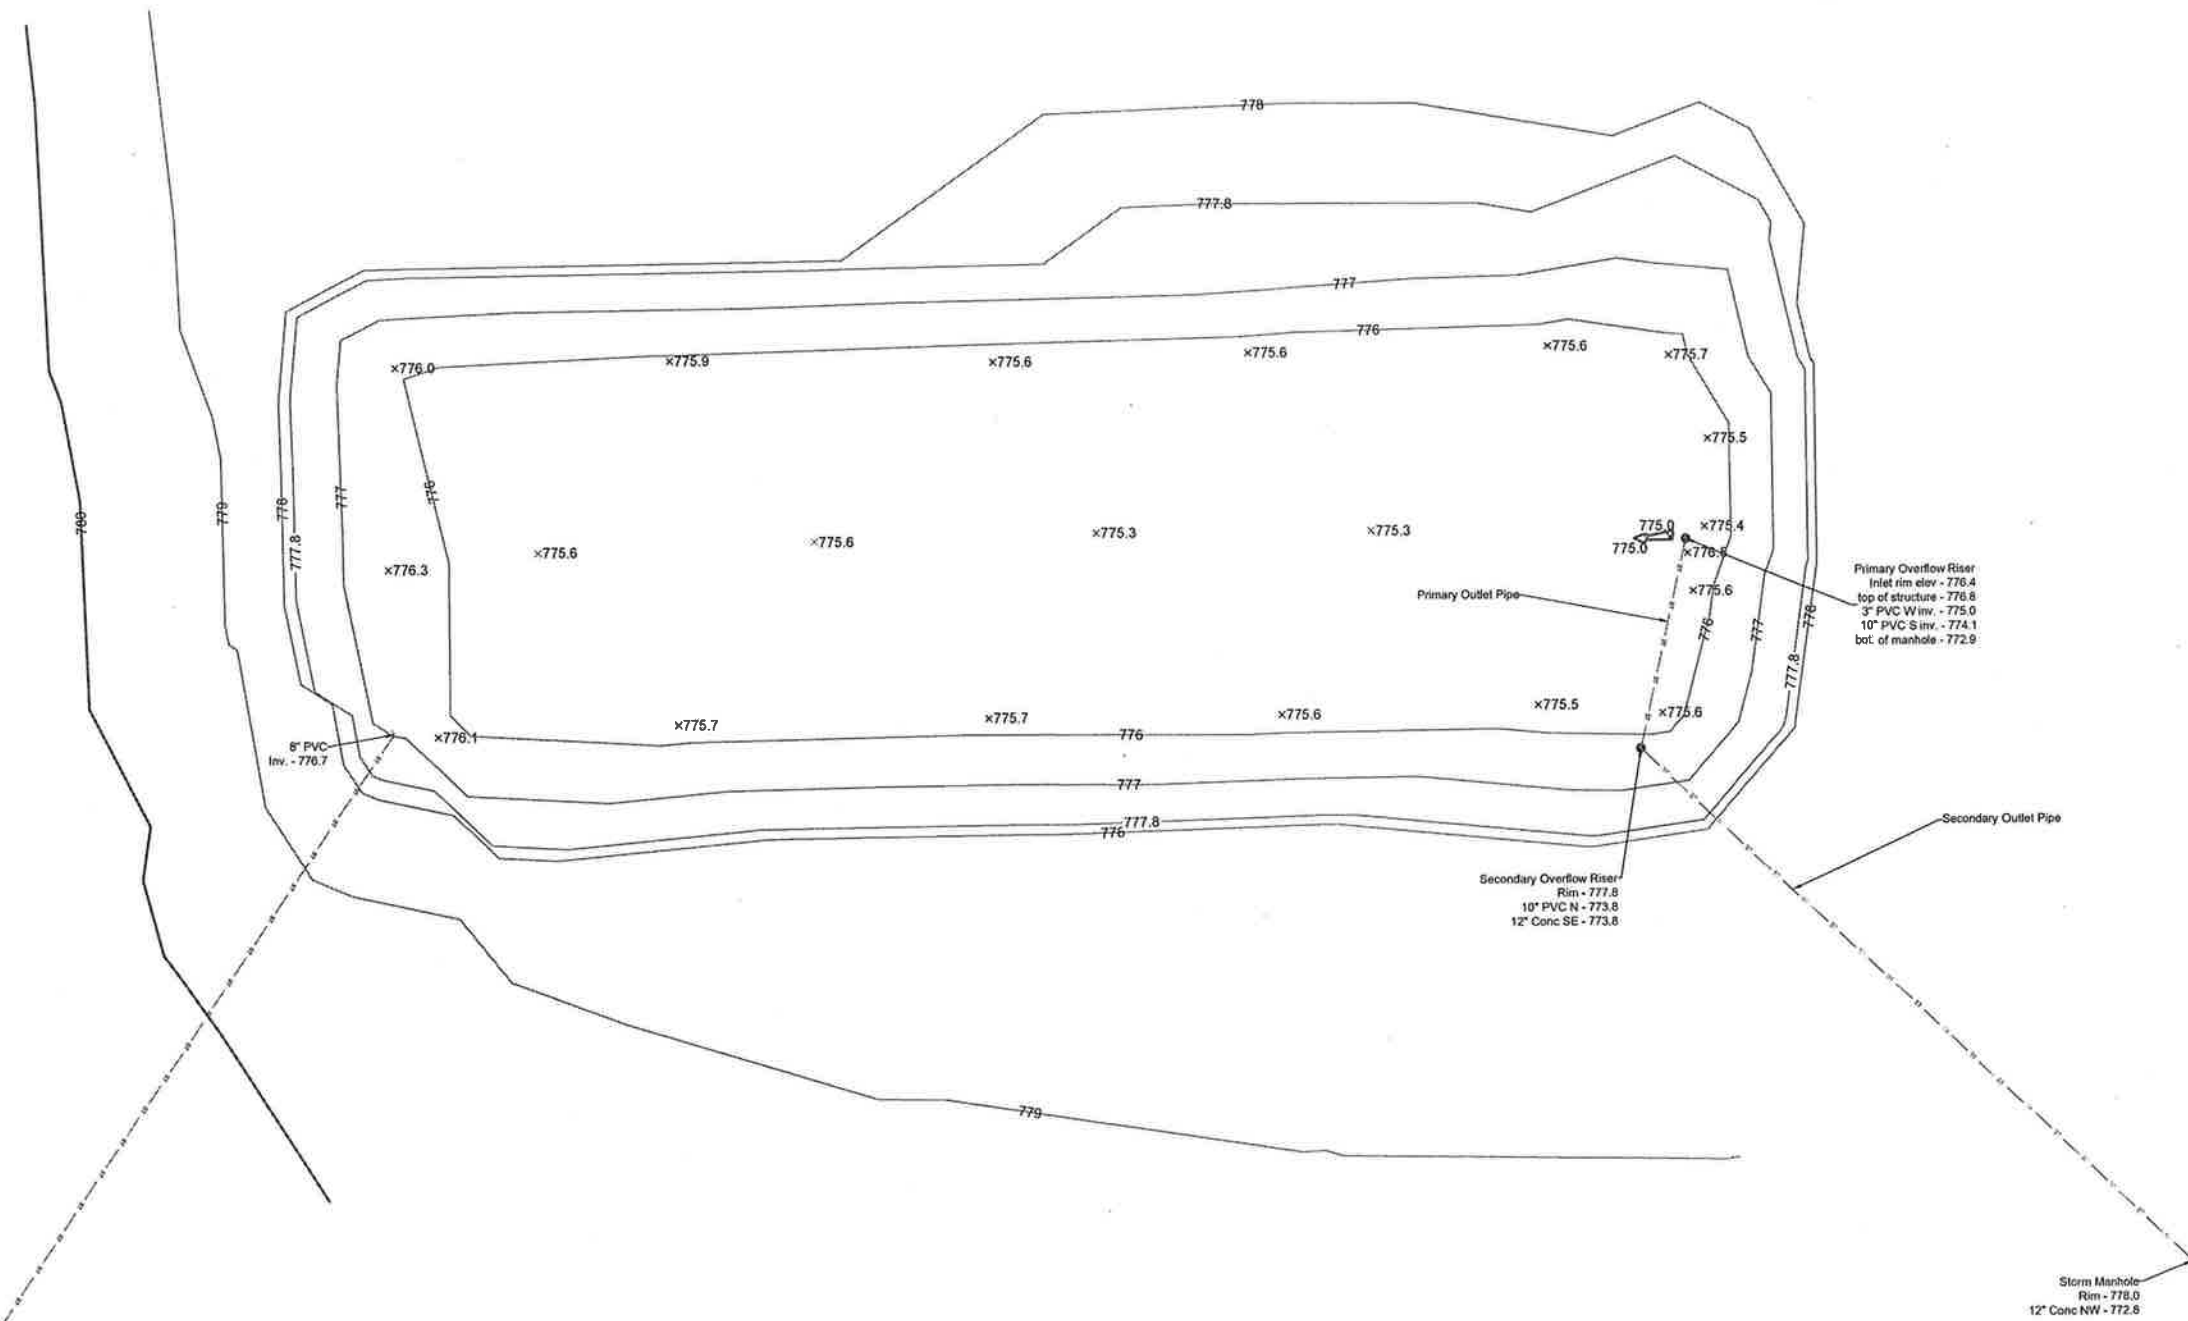

NO. REVISION DATE BY

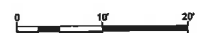

DRAWING NO. 13483-VO30-A.dwg

DRAWN BY: KAS

DATE: October 9, 2012

PROJECT NO: 13483


CHECKED BY: JBL/TPM

APPROVED BY: JBL

SHEET NO.:


SWP02S002

THE SIGMA GROUP
Single Source. Sound Solutions.
www.thesigmagroup.com
1300 West Canal Street
Milwaukee, WI 53233
Phone: 414-643-4200
Fax: 414-643-4210

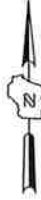

Harley Davidson Motor Company
Pilgrim Road Facility
Menomonee Falls, Wisconsin

Topographic Survey
Pond I.D. SWP02S002

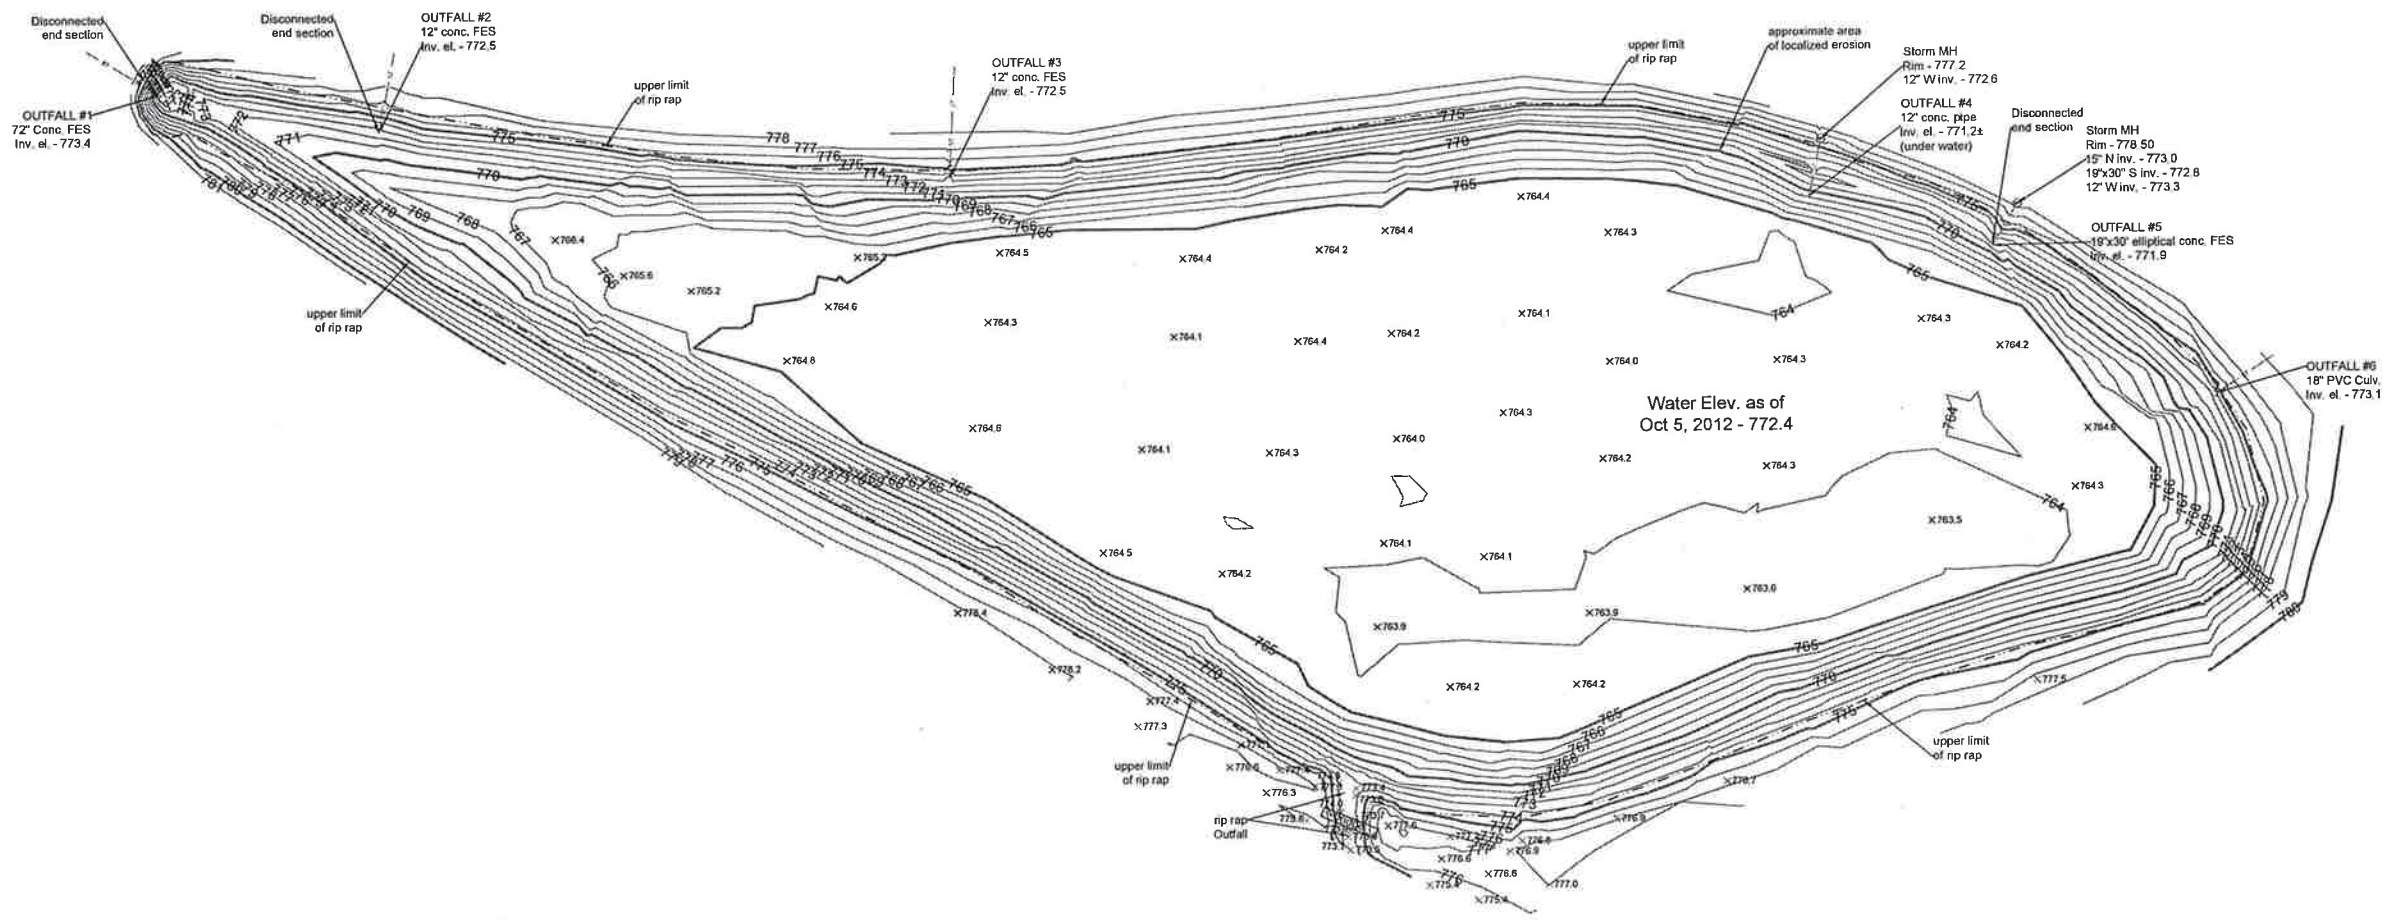

NO. REVISION DATE BY



DRAWING NO. 13483-V030-B.dwg
DRAWN BY: KAS
DATE: October 9, 2012
PROJECT NO: 13483
CHECKED BY: JBL/TPM
APPROVED BY: JBL
SHEET NO.: