



Village of Menomonee Falls
W156 N8480 Pilgrim Road
Menomonee Falls, WI 53051-3140
Telephone: (262) 532-4200

STORMWATER MANAGEMENT FACILITIES OPERATION AND INSPECTION REPORT

Quarter Section
Property Tax ID Number

SE 1/4 Sec 13 Name of Business/Subdivision 401 Woodland Prime
MNF005299 Address of Property W126 N7449 Flint Drive
2014 Menomonee Falls, WI 53051

Date May 17, 2013

| | | | |
|----------|-------------------------------------|------------------|-----------------------|
| Dry Pond | <input checked="" type="checkbox"/> | Location of Pond | South end of building |
| Wet Pond | <input type="checkbox"/> | | |
| Other | <input type="checkbox"/> | | |
| Pond ID: | SWP13s015 | | |

Year Pond Constructed 2008

Year of Last Certification _____

| Compliance Verification | Design | Actual | Compliant Yes | No | Comments (Condition of Structure) |
|------------------------------------------------|---------------|-----------------|-------------------------------------|--------------------------|-------------------------------------------------------------------------------------------------------------------------------------------------------------------------------|
| Primary Outlet Pipe | | | | | |
| Opening Diameter (inches) | 18 | 18 | <input checked="" type="checkbox"/> | <input type="checkbox"/> | Outlet Pipe Material Outlet pipe is located inside of concrete riser structure. Pipe is 18" Corrugated HDPE, and appears to be in good condition. |
| Upstream Invert | 773.79 | 773.90 | <input checked="" type="checkbox"/> | <input type="checkbox"/> | |
| Downstream Invert | 768.10 | 768.10 | <input checked="" type="checkbox"/> | <input type="checkbox"/> | |
| Length (feet) | 220 | 224 | <input checked="" type="checkbox"/> | <input type="checkbox"/> | |
| Slope (%) | 2.6 | 2.6 | <input checked="" type="checkbox"/> | <input type="checkbox"/> | |
| Secondary Outlet Pipe (If Applicable) | | | | | |
| Opening Diameter (inches) | | | | | Outlet Pipe Material |
| Upstream Invert | | | | | |
| Downstream Invert | | | | | |
| Length (feet) | | | | | |
| Slope (%) | | | | | |
| Riser (If Applicable) | | | | | |
| Opening Diameter (inches) | Not specified | 48"x 48" square | | | Riser Material Top opening of concrete riser |
| Elevation | 782.00 | 782.00 | <input checked="" type="checkbox"/> | <input type="checkbox"/> | |
| Upper Discharge Control (If Applicable) | | | | | |
| Opening Diameter (inches) | 3 | 3 | <input checked="" type="checkbox"/> | <input type="checkbox"/> | *The concrete is uneven on the inside of the structure. The surveyor measured the invert at 778.85. I measured down from the top of concrete at exactly 36", therefore 779.00 |
| Elevation | 779.00 | 779.0* | <input checked="" type="checkbox"/> | <input type="checkbox"/> | |

Sketch Outlet or Attach to Document




Attach As-built Survey to the Document for the first report submission

Inspection Firm: Site Engineering Services, LLC
Inspector Name: Martin D. Worden, P.E.
Phone Number: 262/367-4960
Address: 2920 Oakwood Road
Hartland, WI 53029

Certifying Professional Martin D. Worden, P.E.
Name:
Phone Number: 262/367-4960

Date: 5/20/13
Signature:

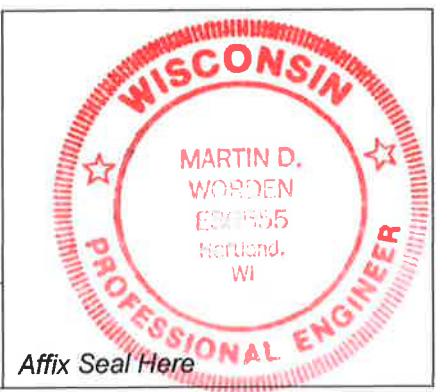

EXHIBIT

SITE ADDRESS

W126 N7449 Flint Drive, Village of Menomonee Falls, Waukesha County, Wisconsin,
being part of the Southeast 1/4 of Section 13, Town 8 North, Range 20 East.


TAX KEY NO.
MNFV0052992014

DATE
May 16, 2013



RIM=786.49

STO RIM=782.51

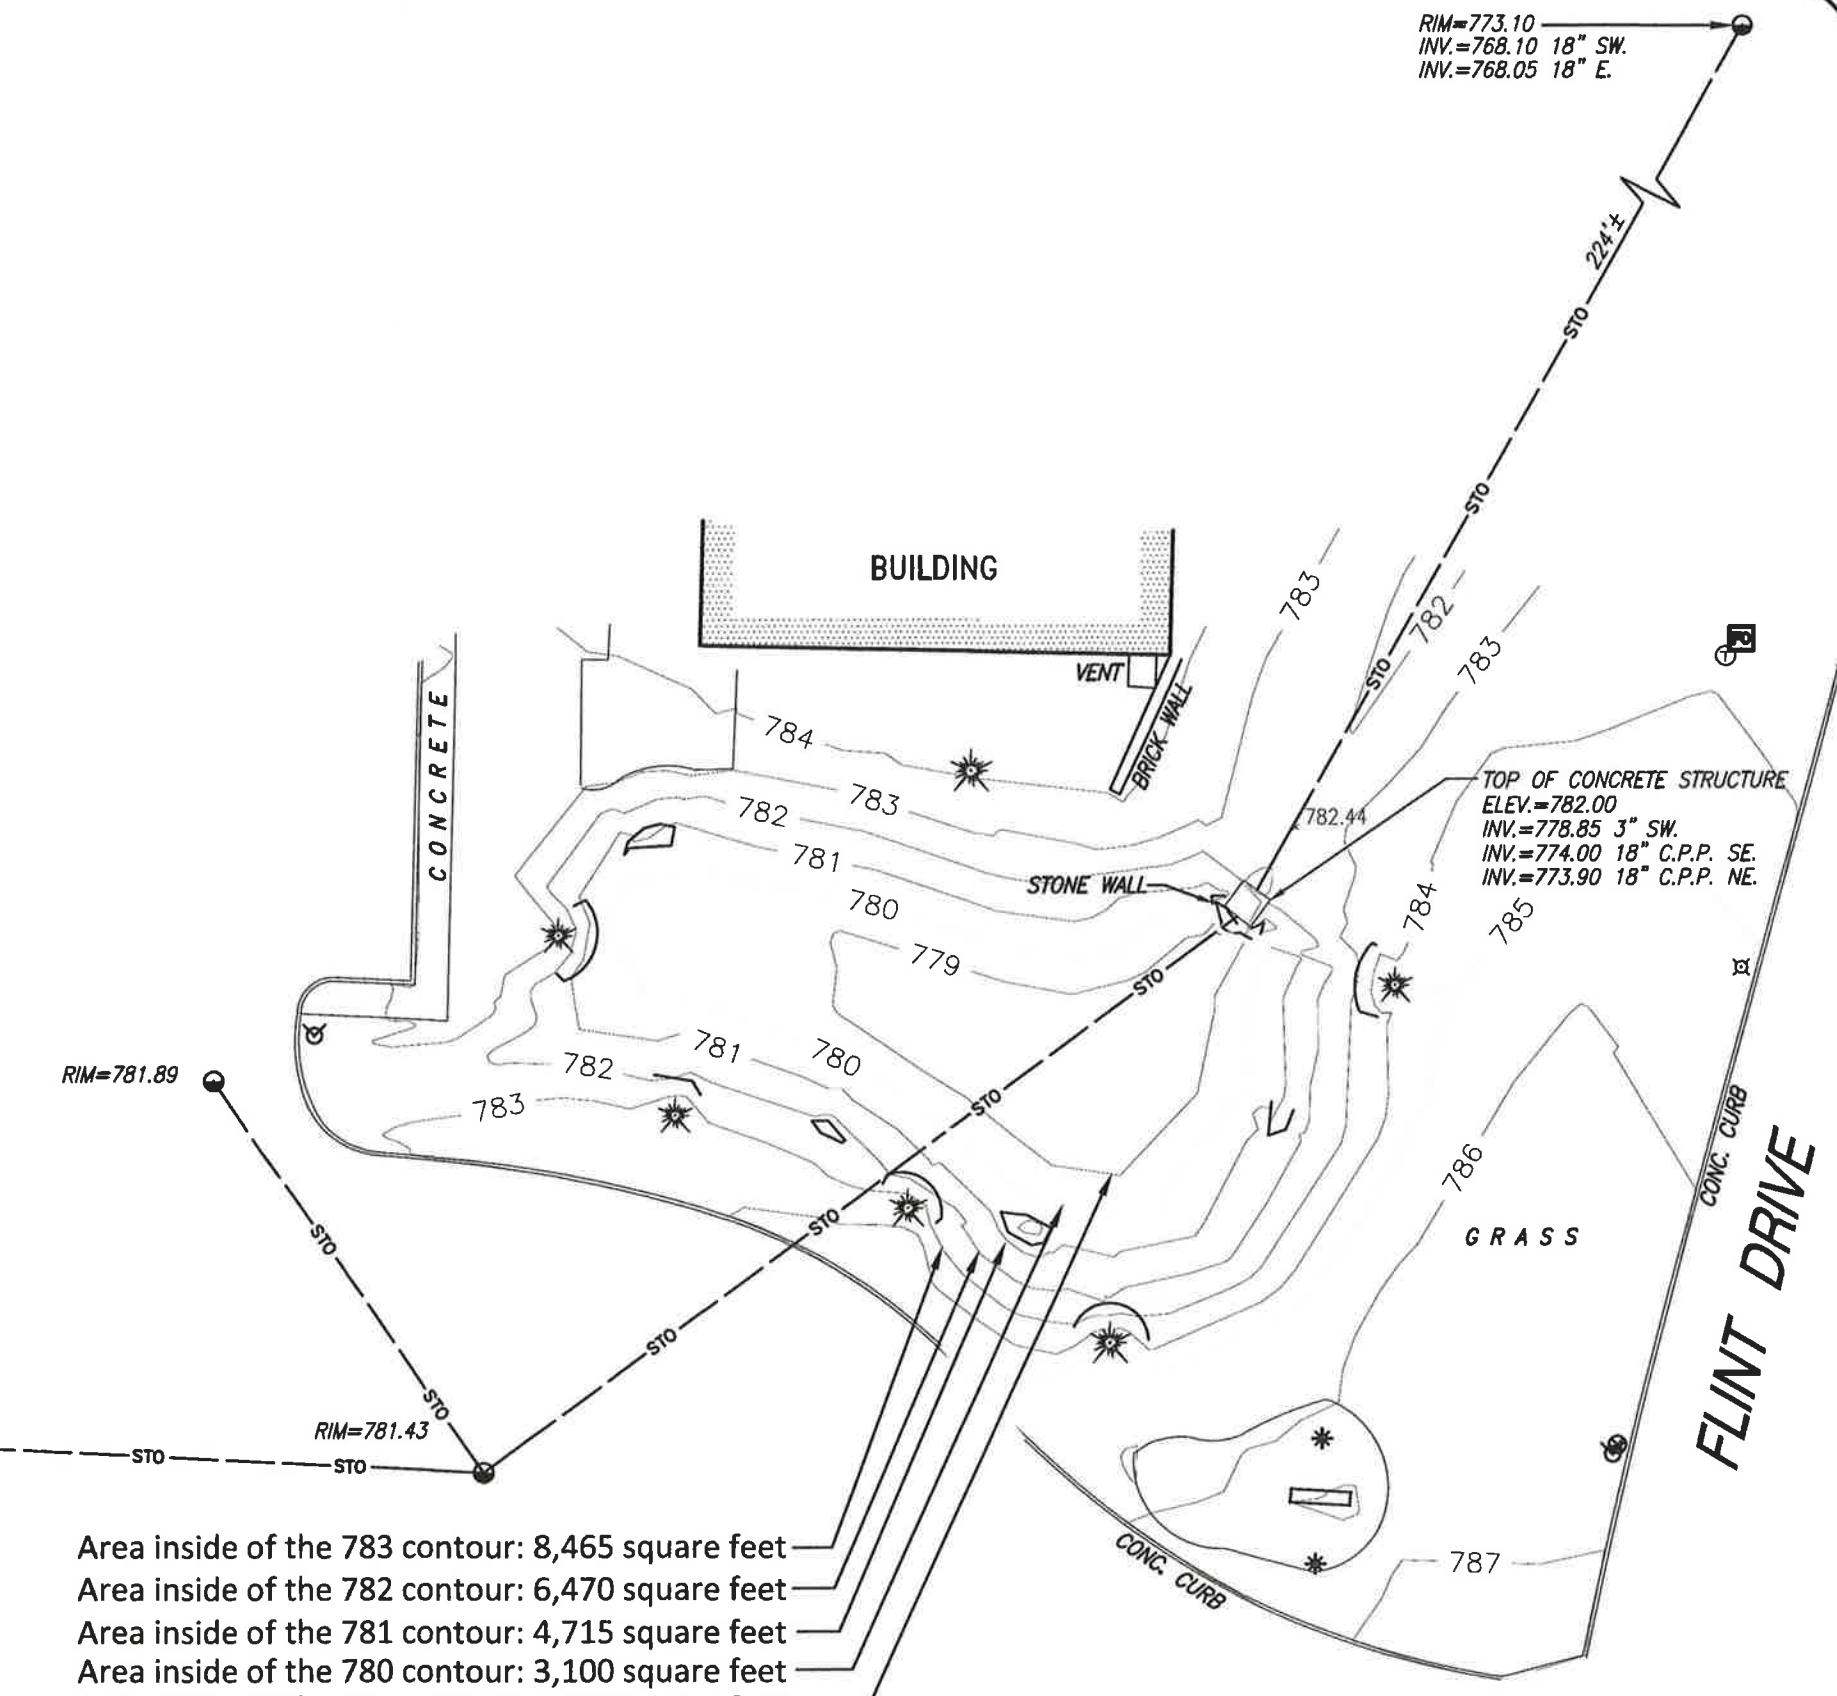

Area inside of the 783 contour: 8,465 square feet
 Area inside of the 782 contour: 6,470 square feet
 Area inside of the 781 contour: 4,715 square feet
 Area inside of the 780 contour: 3,100 square feet
 Area inside of the 779 contour: 1,425 square feet