


CONSULTANTS:

PROJECT TITLE:

FROEDTERT HEALTH CLINIC
 MENOMONEE FALLS, WISCONSIN

ISSUE:

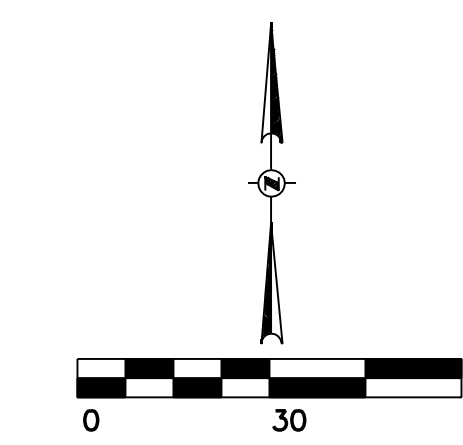

LEGEND

- 870— ASBUILT SUBGRADE MAJOR CONTOUR
- 869— ASBUILT SUBGRADE MINOR CONTOUR
- 870--- PROPOSED MAJOR CONTOUR
- 869--- PROPOSED MINOR CONTOUR
- 871.2--- PROPOSED SUBGRADE CONTOUR


PROJECT INFORMATION:

PROJECT NUMBER: 20100131.00
 DATE: 8/23/10
 DRAWN BY: FKO
 CHECKED BY: CTC
 APPROVED BY: BTP
 SCALE: 1"=30'

SHEET TITLE:

POND ASBUILT

SHEET NUMBER:

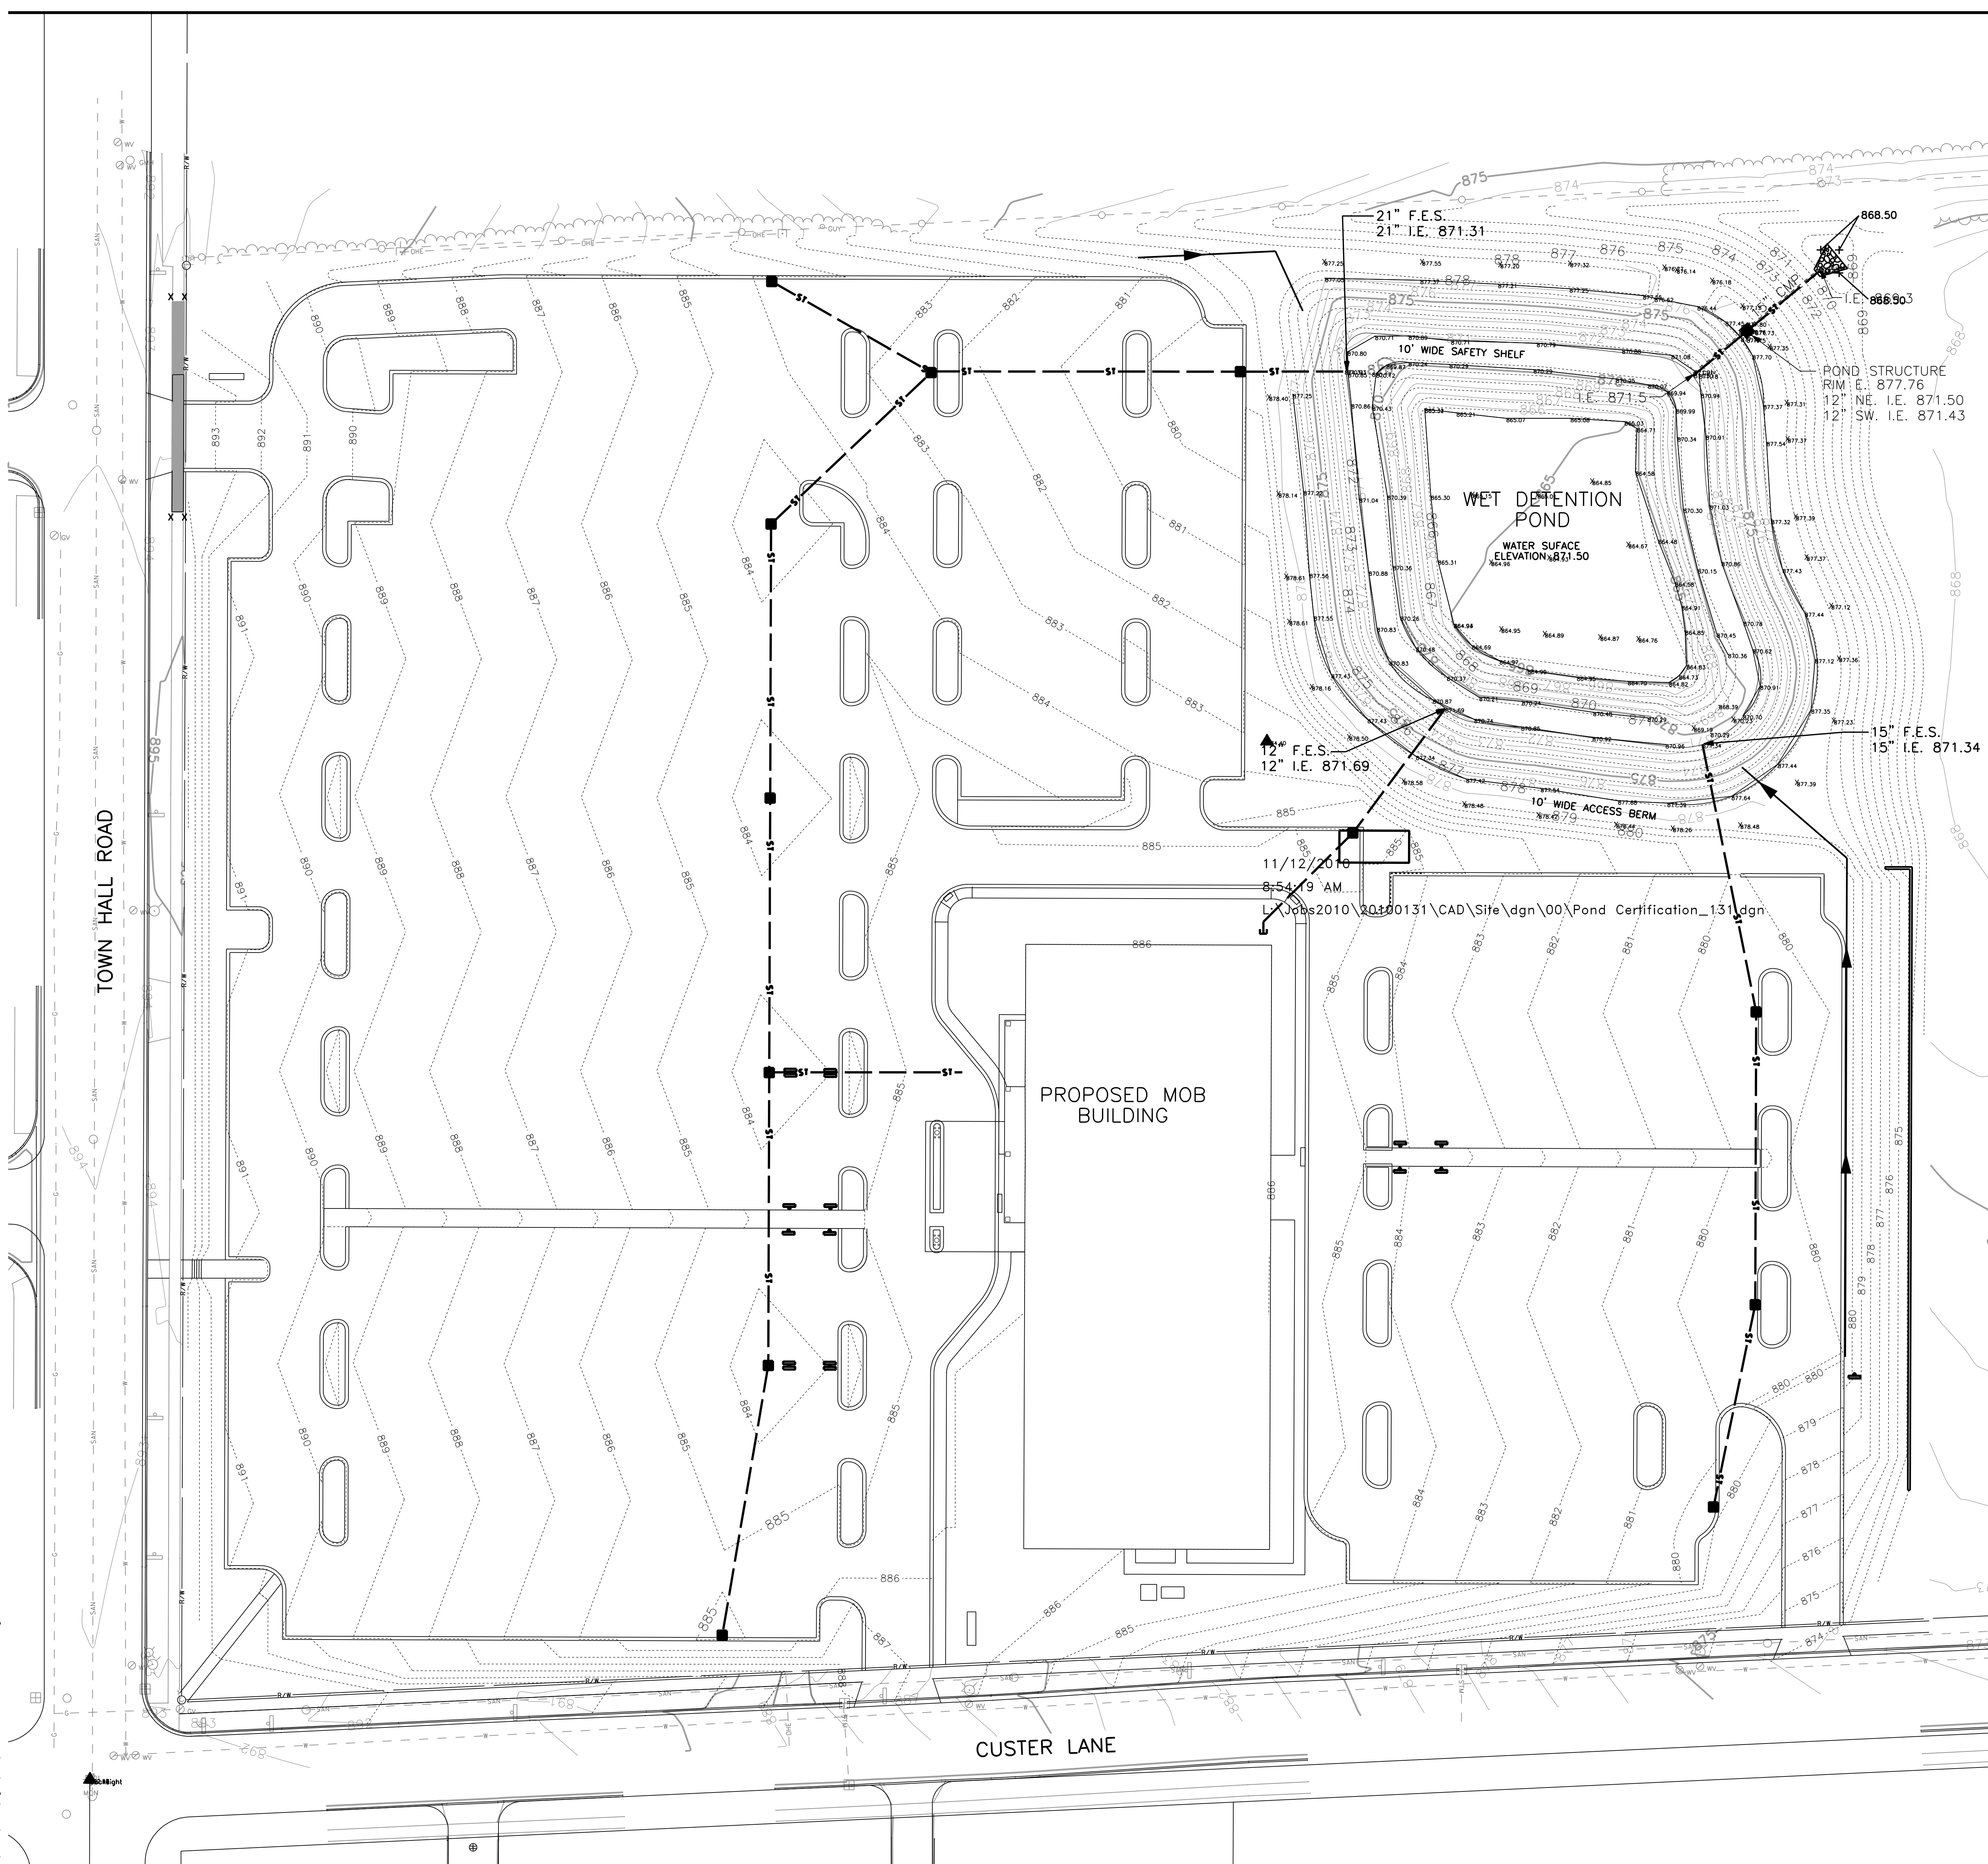

IN ACCORDANCE WITH WISCONSIN STATUTE 182.0175, DAMAGE TO TRANSMISSION FACILITIES, EXCAVATOR SHALL BE SOLELY RESPONSIBLE TO PROVIDE ADVANCE NOTICE TO THE DESIGNATED "ONE CALL SYSTEM" NOT LESS THAN THREE WORKING DAYS PRIOR TO COMMENCEMENT OF ANY EXCAVATION REQUIRED TO PERFORM WORK CONTAINED ON THIS DRAWING, AND FURTHER, EXCAVATOR SHALL COMPLY WITH ALL OTHER REQUIREMENTS OF THIS STATUTE RELATIVE TO EXCAVATOR'S WORK.