



Village of Menomonee Falls  
W156 N8480 Pilgrim Road  
Menomonee Falls, WI 53051-3140  
Telephone: (262) 532-4200

## STORMWATER MANAGEMENT FACILITIES OPERATION AND INSPECTION REPORT

Quarter Section  
Property Tax ID Number  
Date June 12, 2015

NW 1/4 of Sec 25  
MNFV0098151 Name of Business/Subdivision  
Address of Property  
Weyerhaven Subdivision-Phase 1  
Weyerhaven Drive  
Menomonee Falls, WI

Dry Pond		Location of Pond	Large central pond
Wet Pond	X		(east of Weyerhaven Blvd entrance from Lilly Road)
Other			

Year Pond Constructed 2014 Year of Last Certification 2015

Compliance Verification	Design	Actual	Compliant Yes	Comments ( Condition of Structure)
<b>Primary Outlet Pipe</b>				
Opening Diameter (inches)	14x23	14x23	X	Outlet Pipe Material
Upstream Invert	775.7	775.61	X	RCP outlet pipe discharges into ditch line at northeast corner of Lilly Road & Weyerhaven Blvd. Outfall riprap is in good condition.
Downstream Invert	773.64	773.62	X	
Length (feet)	374	374	X	
Slope (%)	0.55	0.53	X	
<b>Secondary Outlet Pipe</b>	(If Applicable)			
Opening Diameter (inches)				Outlet Pipe Material
Upstream Invert				N/A
Downstream Invert				
Length (feet)				
Slope (%)				
<b>Riser</b>	(If Applicable)			
Opening Diameter (inches)	48	48	X	Riser Material
Elevation	779.23	779.24	X	RCP riser structure built in to the western slope of the pond; in good condition.
<b>Upper Discharge Control</b>	(If Applicable)			
Opening Diameter (inches)				
Elevation				


Compliance Verification	Design	Actual	Compliant Yes No		Comments	
<b>Lower Discharge Control</b>	(If Applicable)					
Opening Diameter (inches)	4.5	4.5	X		The low discharge control in Phase 1 is a 4.5" diameter orifice cored into the end of a cap on the 15" diameter PVC outlet pipe extending from the water's edge to the RCP riser structure.	
Elevation	776.3	776.35	X			
<b>Other (Description)</b>						
Opening Type and Size (inches)	19x30	19x30	X		(3) – 19"x30" RCP outlet pipes (with poured in place endwalls) across Weyerhaven Drive provide conveyance of emergency spillway runoff (for events >100-year storm).	
Elevation	777.32	777.23	X			
<b>Emergency Spillway</b>						
Elevation	780.0	780.09	X		Grass vegetation established.	
Length of spillway (feet)	20	20	X			
<b>Embankment</b>	Present Yes no		Comments/Maintenance Requirements			
Unauthorized Plantings, trees, or woody vegetation		X	Slope erosion in southeast corner adjacent to upslope wetland. Regrade to uniform slope and install erosion mat over geofabric or geosynthetic channel erosion matting with seed.			
Animal burrows or slope erosion	X					
<b>Storm Sewer Outfalls</b>	Type & Size		Location		Comments	
Outfall 1	30" RCP		West embankment		Stabilized outfall	
Outfall 2	18" RCP		Northeast Corner		Stabilized outfall	
Outfall 3	33" RCP		Southeast Corner		Stabilized outfall	
<b>Storage Properties</b>	Design	Actual	Compliant Yes	No	Not Applicable	Equipment Used
Normal Water Elevation (Wet Ponds)	776.3	776.35	X			GPS (Navcom)
Design High Water Elevation	779.6	779.6	X			GPS (Navcom)
Area at Normal Water Elevation (Ac) (Wet Ponds)	1.28	1.29	X			
Area at Design High Water Elevation (Ac)	1.84	1.86	X			
Active Storage Available (Ac-Ft)*	4.72	4.71	X			
Lowest Elevation at Top of Embankment (If Applicable)	781.0	781.34	X			GPS (Navcom)
Average Elevation at Top of Embankment (If Applicable)	781.0	781.37	X			GPS (Navcom)
Maximum Bottom Elevation	763.0	762.79	X			GPS (Navcom)
Average Pond Bottom Elevation	763.0	762.8	X			
Pond Bottom Area (Ac)	0.31	0.31	X			
Maximum Pond Depth	3.7	3.74	X			For ponding depth between Normal Water Elevation and Overflow Spillway
Average Pond Depth	3.7	3.74	X			
Average Permanent Pool Depth (Wet Ponds)	13.3	13.55	X			

\*To Determine Active Storage  $V=H/3(A1+A2+(A1 \times A2)1/2)$

Wet Ponds Use  $H$  = Height of Section,  $A1$  = area at normal water elevation,  $A2$  = area at top section

Dry Ponds Use  $H$  = Height of Section,  $A1$  = pond bottom area,  $A2$  = area at top section

Sketch Outlet or Attach to Document

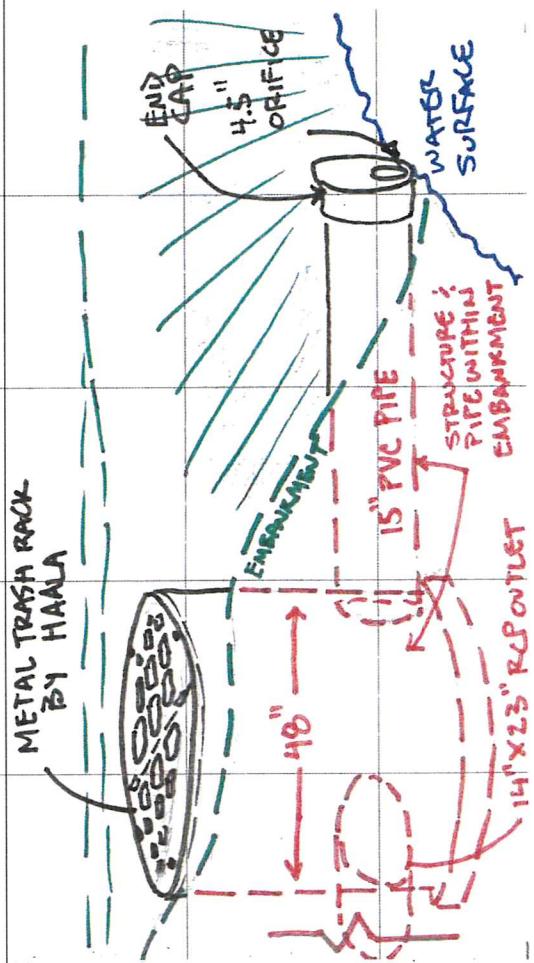

Attach As-built Survey to the Document for the first report submission

Inspection Firm: Trio Engineering, LLC  
Phone Number: 262-790-1480  
Address: 12660 W. North Avenue  
Brookfield, WI 53005

Inspector Name: Joshua D. Pudelko, PE  
Inspection Date: June 12, 2015

Certifying Professional

Name: Joshua D. Pudelko, PE  
Phone Number: 262-790-1480

Date:

6/15/15

Signature:

