



RECORD / AS-BUILT DRAWING

STORM WATER DETENTION POND (WET)
HIGH POINT COMMONS
W. SILVER SPRING DR. & LILLY RD.
MENOMONEE FALLS, WI 53051

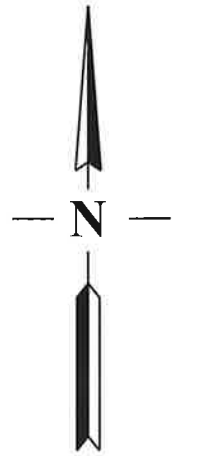

SCALE 1" = 30'

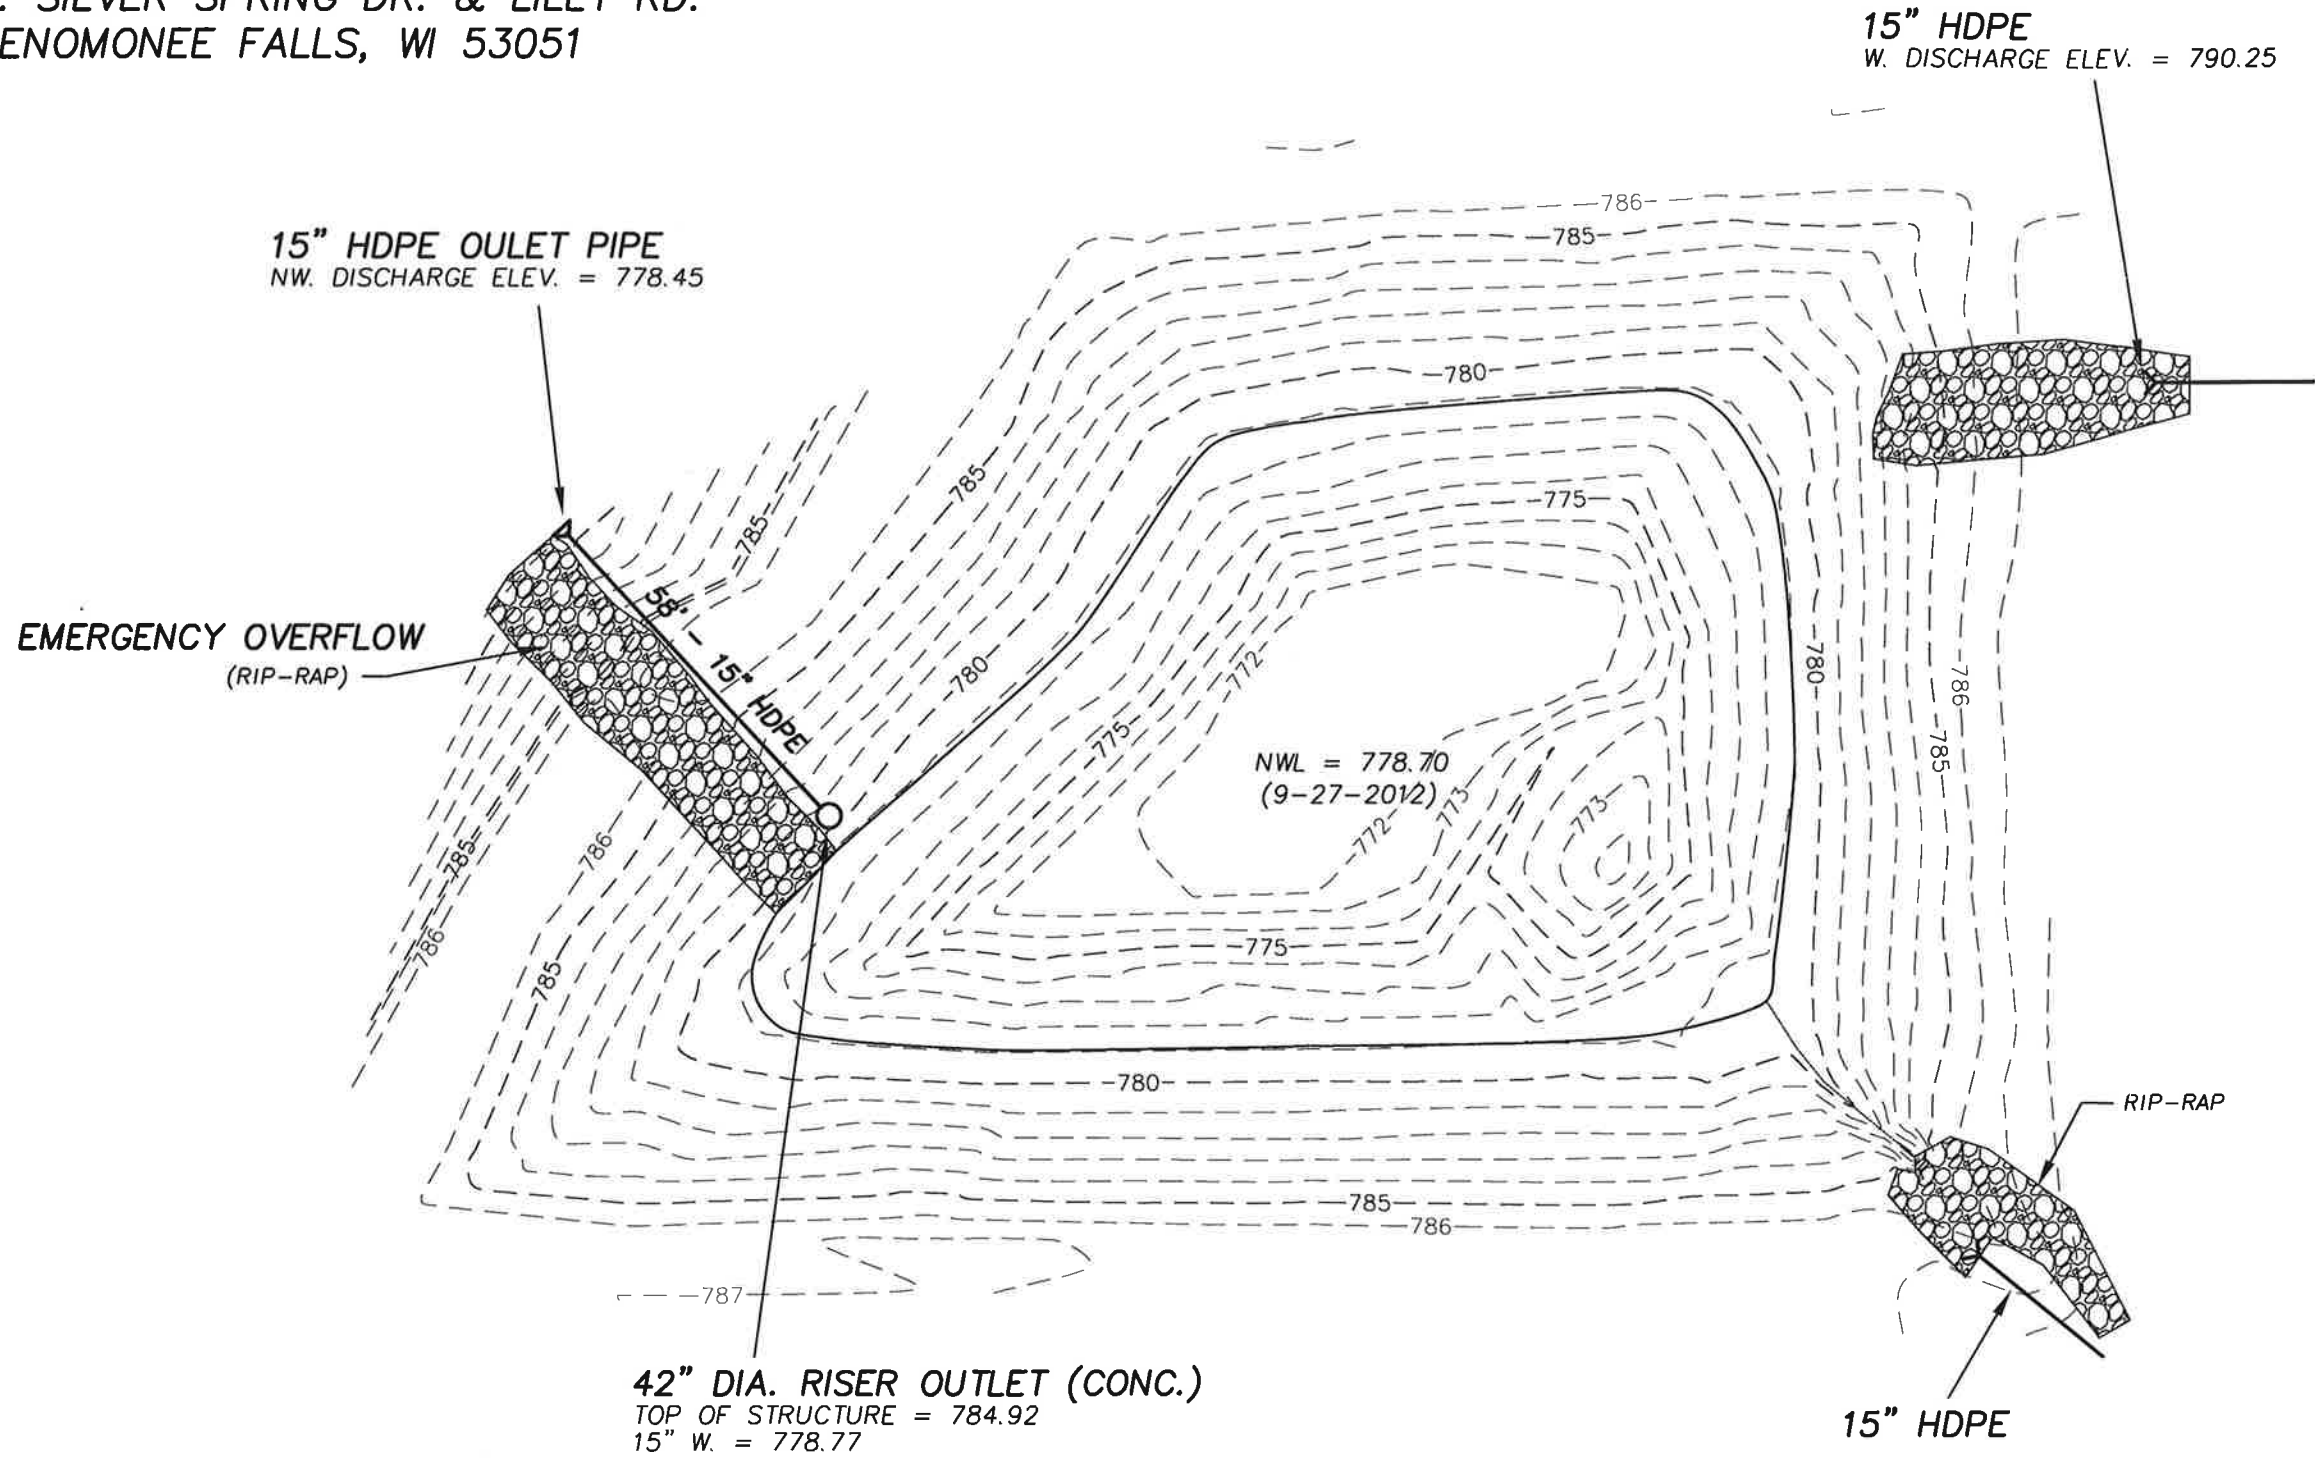

NORTH SHORE ENGINEERING, INC.
Consulting Engineers & Land Surveyors
11433 N. Port Washington Rd., Mequon, Wisconsin, 53092
(262) 241-9400 • FAX: (262) 241-5337



SCALE: 1" = 30'