


REFERENCE BENCHMARK
NE FLANGE BOLT ON HYDRANT
EL.=783.96

#7859

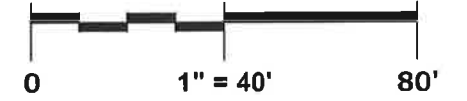

GRAPHICAL SCALE (FEET)



CRUSHED 24" CMP
N. INV.=781.04
S. INV.=782.4+/-

8" PP
INV.=782.79


EDGE OF CONCRETE PAVEMENT

OUTFALL STRUCTURE
TOP OF RIM EL.=785.40
TOP OF BEEHIVE GRATE EL.=786.3
8" PP NW=783.05
TOP OF 8" RISER EL.=785.23
BOTTOM EL.=781.00

PARCEL 3
C.S.M. NO. 8763

UNION PACIFIC RAILROAD

LILLY ROAD

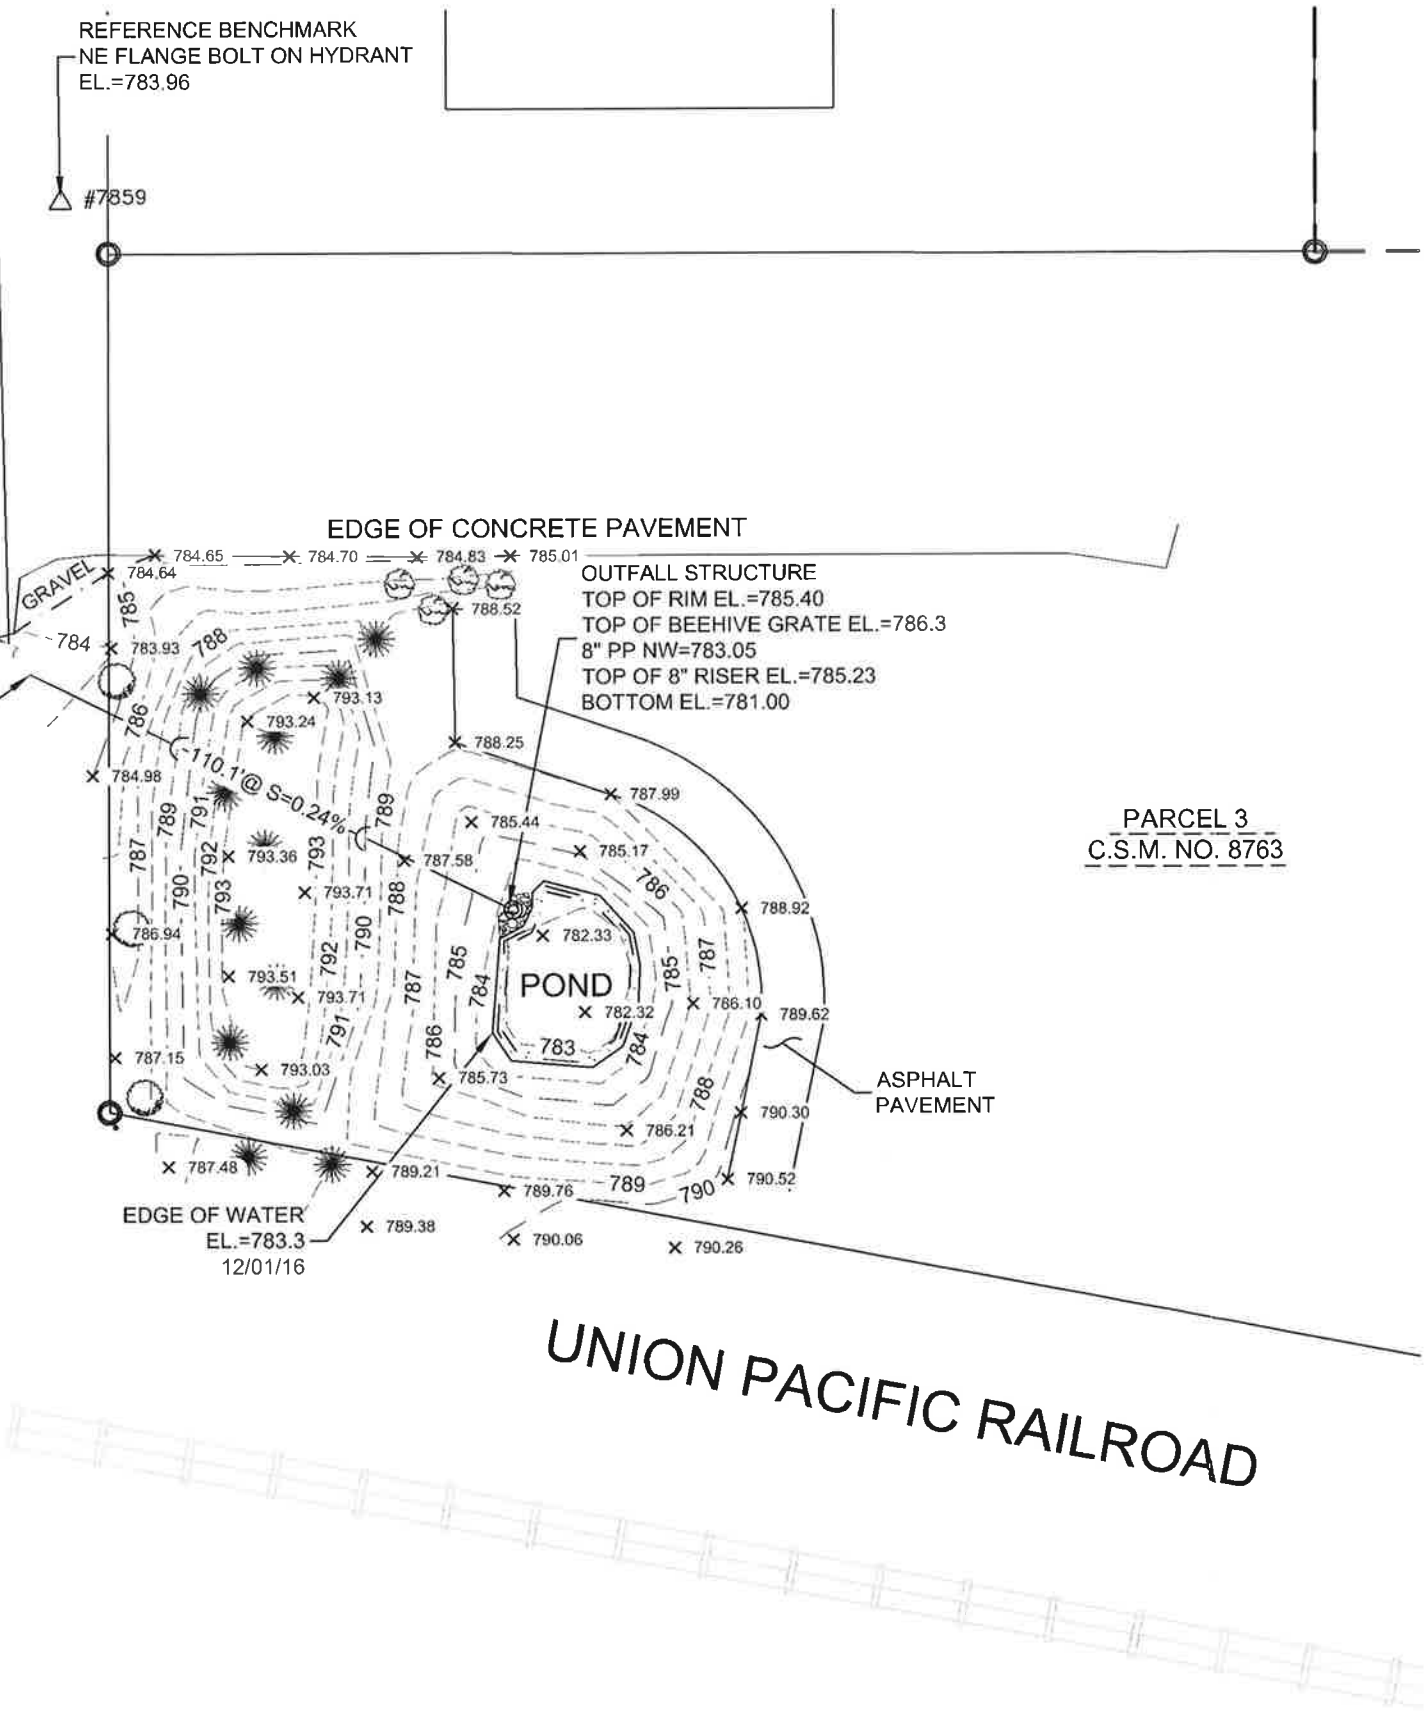

POND ASBUILT EXHIBIT - W140 N5998 LILLY ROAD, MENOMONEE FALLS, WI

12/01/16



PINNACLE ENGINEERING GROUP

5850 W. BLUEMOUND ROAD | SUITE 210 | BROOKFIELD, WI 53005 | WWW.PINNACLE-ENGR.COM

PLAN | DESIGN | DELIVER

PEG JOB#374.10