


STORMWATER POND ASBUILT SURVEY

W178 N9379 WATER TOWER PLACE
MENDOTA FALLS, WI

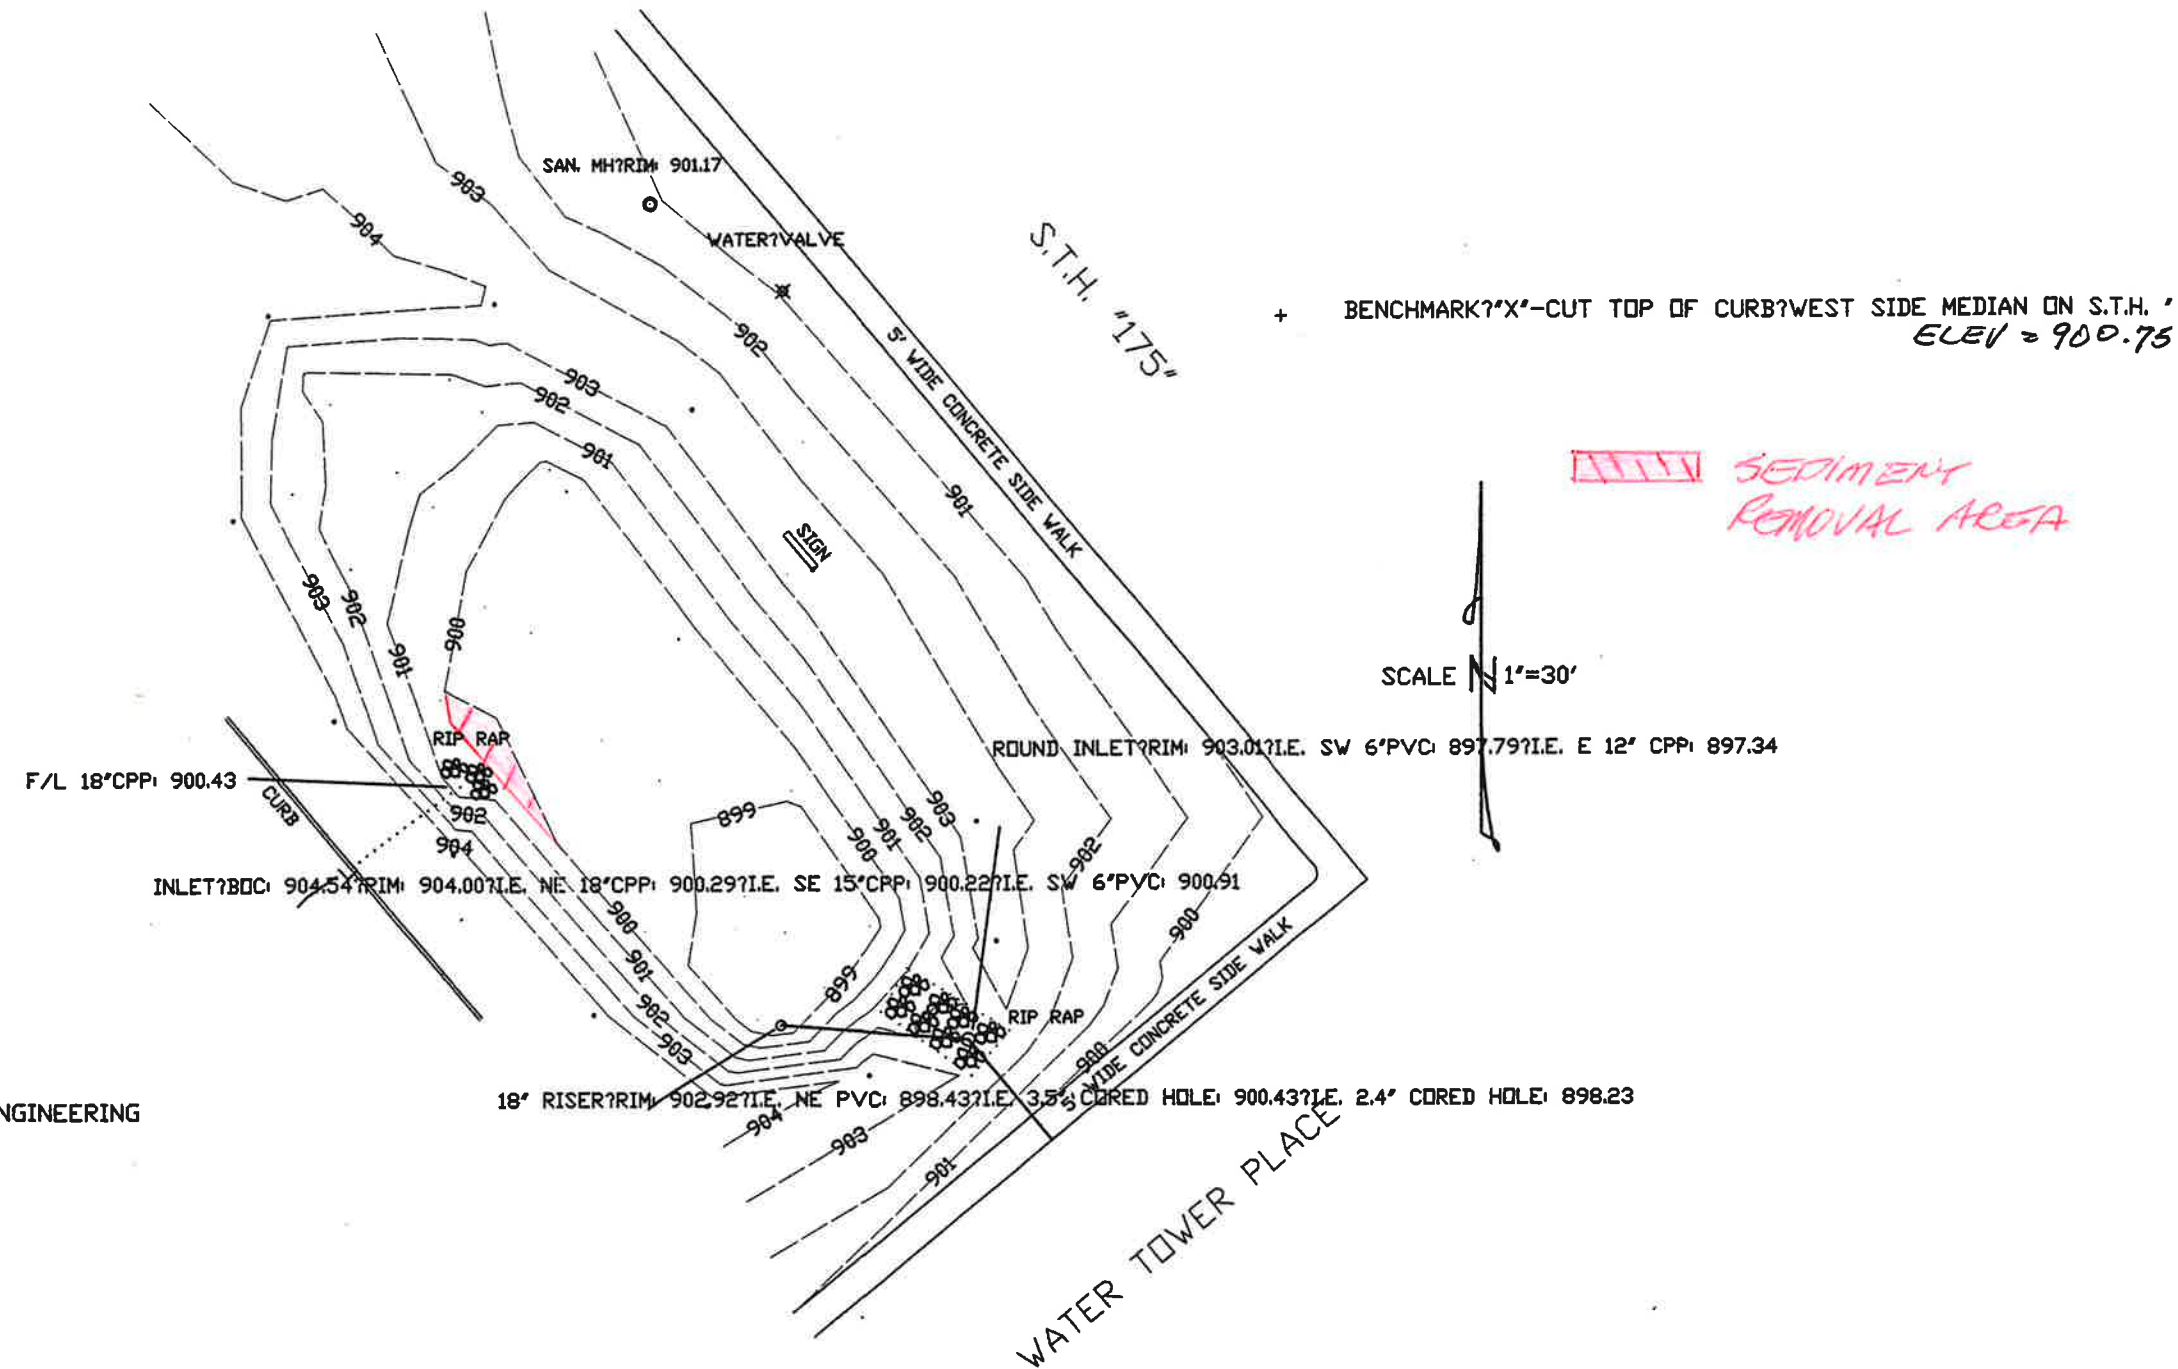

PREPARED FOR: TRANTREE ENGINEERING

f_/users/land/cer1 F:\SiteComp\CER
SURVEYED BY
MICHAEL W. BUECHL, INC.
233 OAKTON AVE.
PEWAUKEE, WISCONSIN 53072
PHONE
1-262-691-4444
FAX
1-262-691-4465

Michael W Buechl

