



WET POND CROSS SECTION

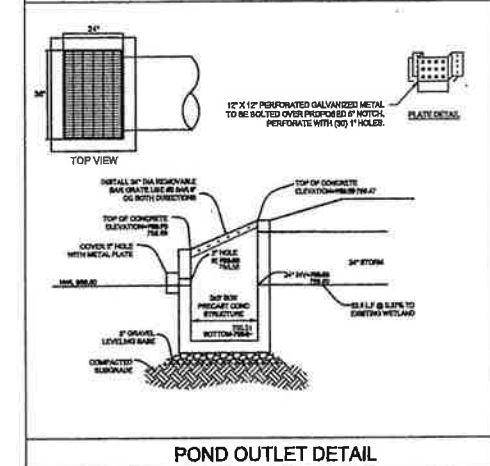

POND OUTLET DETAIL

Wet Pond 1		
Elevation	Proposed	As-Built
761	15312	14833
762	16293	16081
763	17308	17364
764	18329	18695
765	19404	20052
766	20507	23036
767	27938	27645
768	30556	30568
769	33295	33593
770	36206	36884
771	41058	42826
772	49658	49723

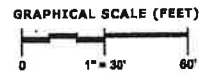

BY WETLAND CONSULTING
5, 2014
(.6335 AC)

LOT 3 BLOCK 4
STARLITE MANOR

