



Village of Menomonee Falls  
W156 N8480 Pilgrim Road  
Menomonee Falls, WI 53051-3140  
Telephone: (262) 532-4200

## STORMWATER MANAGEMENT FACILITIES OPERATION AND INSPECTION REPORT

Quarter Section NW 1/4 Sec.  
 36-8-20  
 Property Tax ID Number 0142999010 Name of Business/Subdivision Capital Heating and Cooling  
 Address of Property W134 N5368 Campbell Dr.

Dry Pond	<input checked="" type="checkbox"/>
Wet Pond	<input type="checkbox"/>
Other	<input type="checkbox"/>

Description: SWP36N003

Location Of  
Pond

Basin is located east of building

Year Pond Constructed 2006

Year of Last Certification 2015


Compliance Verification	Design	Actual	Compliant Yes	Non-Compliant No	Comments (Condition of Structure)
<b>Primary Outlet Pipe</b>					
Opening Diameter (inches)	1.6"	1.6"	X		Outlet pipe is 8" in diameter, capped, with a 1.6" orifice hole drilled into cap
Upstream Invert	741.00	741.19	X		See Photo #1
Downstream Invert	740.00	740.10	X		
Length (feet)	69'	69'	X		
Slope (%)	1.45%	1.58%	X		
<b>Secondary Outlet Pipe</b>					
Opening Diameter (inches)					Not Applicable - no secondary outlet
Upstream Invert					
Downstream Invert					
Length (feet)					
Slope (%)					
<b>Riser</b>					
Opening Diameter (inches)	24"	24"	X		24" Concrete Structure w/beehive gate
Elevation	744.50	744.55	X		See Photo #2
<b>Upper Discharge Control</b>					
Opening Diameter (inches)					
Elevation					

Compliance Verification	Design	Actual	Compliant Yes      No	Comments	
<b>Lower Discharge Control</b> (If Applicable)					
Opening Diameter (inches)					
Elevation					
<b>Other (Description)</b>					
Opening Type and Size (inches)					
Elevation					
<b>Emergency Spillway</b>					
Elevation	746.30	746.10	X	See Photo #3, weedy vegetation should be removed	
Length of spillway (feet)	25'	24.5'	X		
<b>Embankment</b>	Present Yes	no		Comments/Maintenance Requirements	
Unauthorized Plantings, trees, or woody vegetation	X			See Photo #4 and #5, the bottom and side slopes of the basin is recommended to be mowed twice per year to a 6"-8" height, all woody vegetation and trees shall be removed	
Animal burrows or slope erosion		X			
<b>Storm Sewer Outfalls</b>	Type & Size		Location	Comments	
Outfall 1	6" PVC		West slope of basin	Significant erosion, recommend restoring riprap outfall, see Photo #6	
Outfall 2					
Outfall 3					
<b>Storage Properties</b>	Design	Actual	Compliant Yes      No	Not Applicable	Equipment Used
Normal Water Elevation (Wet Ponds)				X	Laser Level, utilizing outlet structure grate as benchmark elevation
Design High Water Elevation	744.32	744.59	X		Water levels and areas calculated utilizing AutoCAD and HydroCAD
Area at Normal Water Elevation (Ac) (Wet Ponds)				X	
Area at Design High Water Elevation (Ac)	0.096	0.092	X		
Active Storage Available (Ac-Ft)*	0.501	0.463	X		
Lowest Elevation at Top of Embankment (If Applicable)	746.30	746.73	X		
Average Elevation at Top of Embankment (If Applicable)	747.00	747.08	X		
Maximum Bottom Elevation	741.00	741.19	X		
Average Pond Bottom Elevation	741.00	741.32	X		
Pond Bottom Area (Ac)	0.014	0.011	X		
Maximum Pond Depth	5.3'	5.54'	X		
Average Pond Depth				X	
Average Permanent Pool Depth (Wet Ponds)				X	

\*To Determine Active Storage  $V = ((H/3)(A_1 + A_2 + ((A_1 + A_2)^{(\frac{1}{2})})))$

Wet Ponds Use  $H = \text{Height of Section}$ ,  $A_1 = \text{area at normal water elevation}$ ,  $A_2 = \text{area at top section}$

Dry Ponds Use  $H = \text{Height of Section}$ ,  $A_1 = \text{pond bottom area}$ ,  $A_2 = \text{area at top section}$

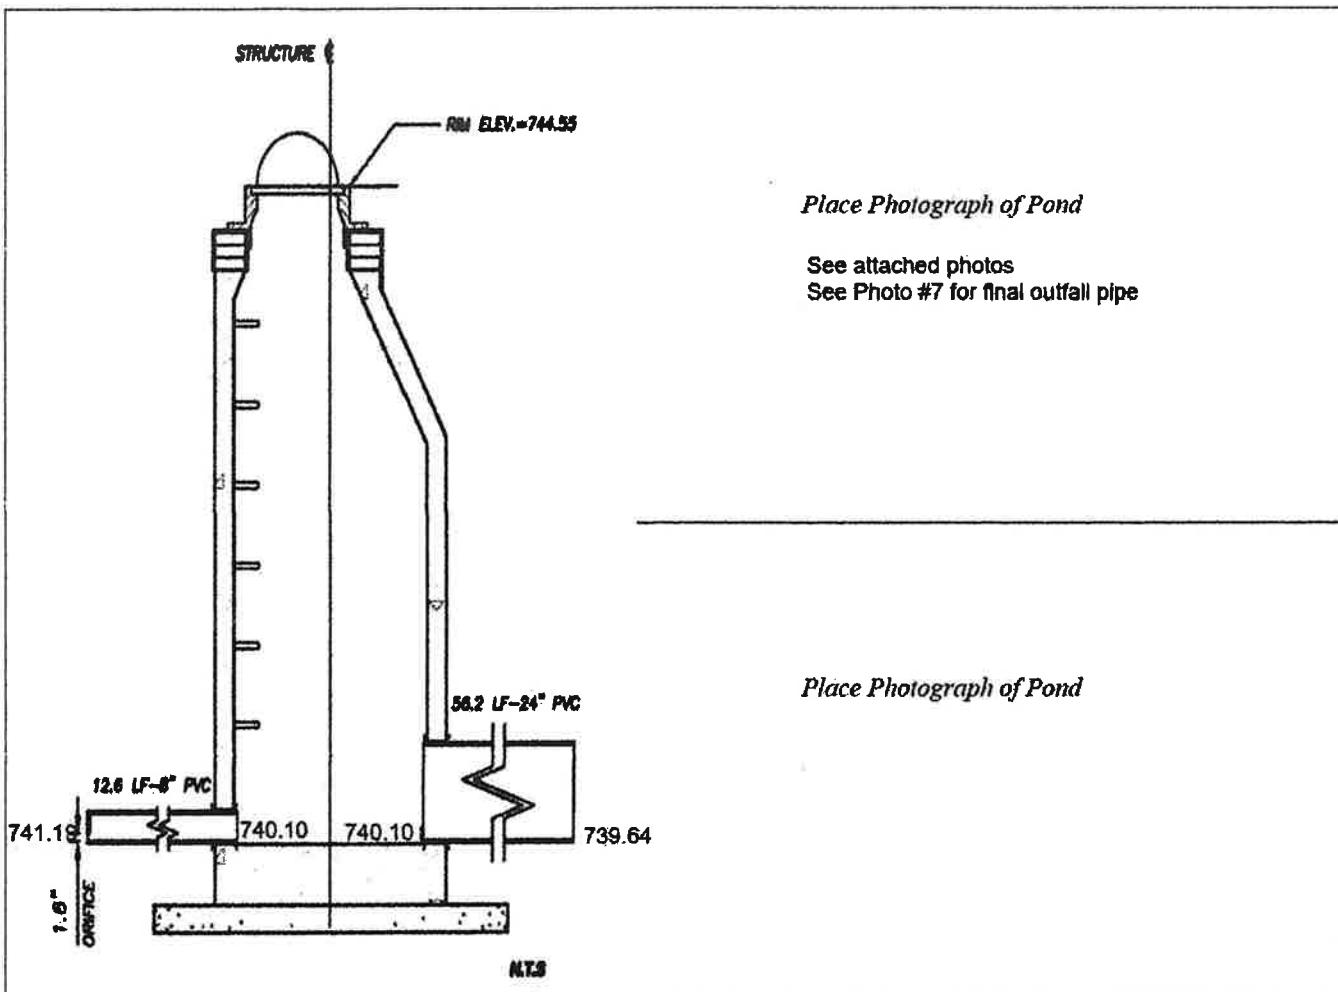

Inspection Firm: Drainage Doctor, LLC  
 Phone Number: 608.535.9380  
 Address: 418 W Red Pine Circle  
Dousman, WI 53811

Inspector Name: Tyler Smith, PE  
 Inspection Date: October 14, 2020

Certifying  
 Professional Name: Tyler Smith, PE  
 Phone Number: 608.535.9380

Date: <u>10/26/2020</u>	Signature: <u>Tyler Smith</u>
-------------------------	-------------------------------





**PHOTOS**  
**October 14, 2020**



**Photo #1: Outlet pipe with 1.6" orifice**



**Photo #2: Outlet structure/stand pipe**



Photo #3: Emergency Spillway



Photo #4: Overall basin looking south



14/10/2020 09:04:17 AM

Photo #5: Overall basin, looking north



14/10/2020 09:03:53 AM

Photo #6: Erosion at 6" outfall pipe



14/10/2020 09:04:57 AM

**Photo #7: Basin outfall pipe**