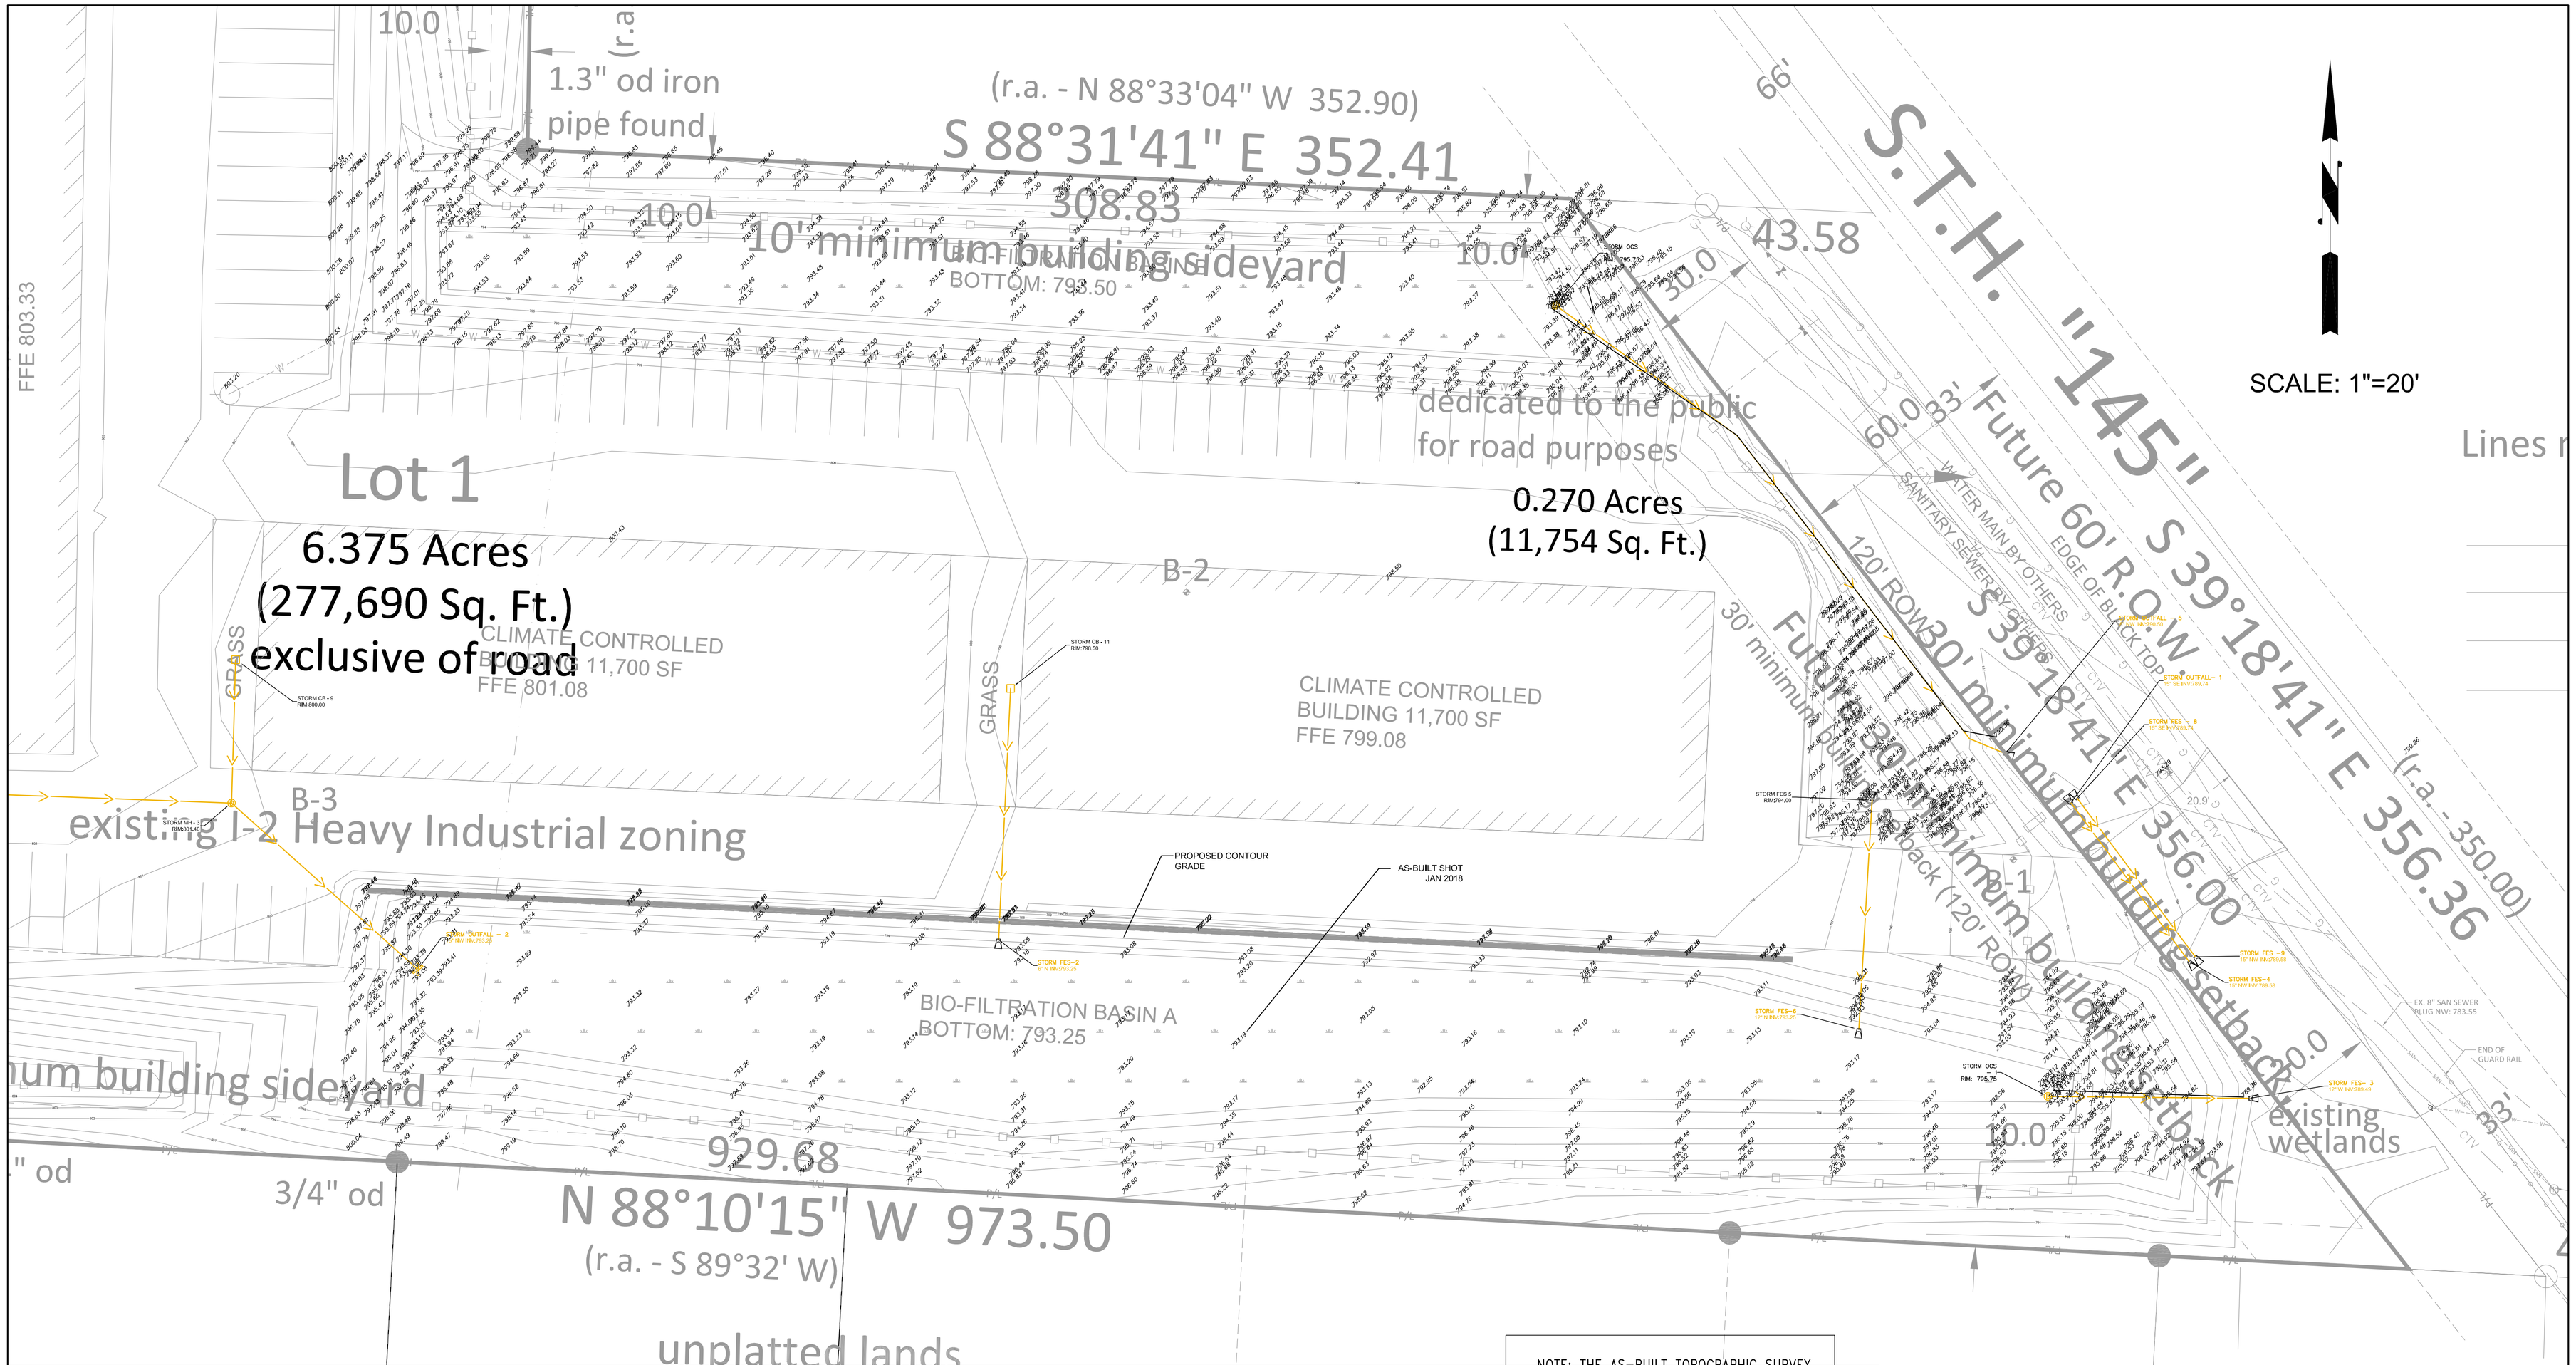

NOTE: THE AS-BUILT TOPOGRAPHIC SURVEY INFORMATION SHOWN HEREON WAS COLLECTED AND SUPPLIED BY HOMELAND SURVEYING IN JANUARY 2018.
I CERTIFY THAT TO THE BEST OF KNOWLEDGE THE GRADES SHOWN HEREON ARE ACCURATE AND REPRESENT THE AS-BUILT CONDITIONS.

Mark R. Ellena

MARK R. ELLENA, PE

THE UNDERGROUND UTILITY INFORMATION AS SHOWN HEREON IS BASED, IN PART, UPON INFORMATION FURNISHED BY UTILITY COMPANIES AND THE LOCAL MUNICIPALITY. WHILE THIS INFORMATION IS BELIEVED TO BE RELIABLE, ITS ACCURACY AND COMPLETENESS CANNOT BE GUARANTEED NOR CERTIFIED TO.

REVISIONS	
DATE	DESC

WISCONSIN
MARK R. ELLENA
E-24090
WALES, WI
PROFESSIONAL ENGINEER

EEC
ELLENA ENGINEERING CONSULTANTS, LLC
SITE CIVIL ENGINEERING & STORMWATER MANAGEMENT
Ellena Engineering Consultants, LLC • 700 Pilgrim Parkway - Suite 100 • Elm Grove, WI 53122
Phone: 262-719-6183 • Fax: 866-457-2584 • Email: mellena@eeceng.com

VILLAGE OF MENOMONEE FALLS

MENOMONEE FALLS STORAGE - SWM IMPROVEMENTS

Pond A & B As-Built Plan

SCALE: H: 1"=20'

DATE: 01-31-18

AB100